



CERTIFIED LAND CORNER RESTORATION

Index No. **K-25**

State of Wisconsin } ss.
 County of Oneida

I Philip T. Hansen do hereby certify that on the 15th day of May 19 75 I found evidence of the N-1/16 corner of Sections 13 and 18 Township 35 North, Range 11 and 12 E Fourth Principal Meridian, as described hereon; and that from this evidence I established a new monument and accessories as described hereon to perpetuate the original location of this corner.

Resident witnesses:

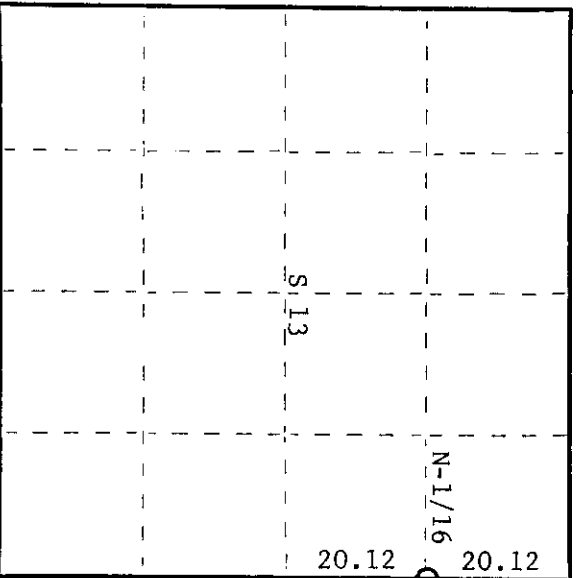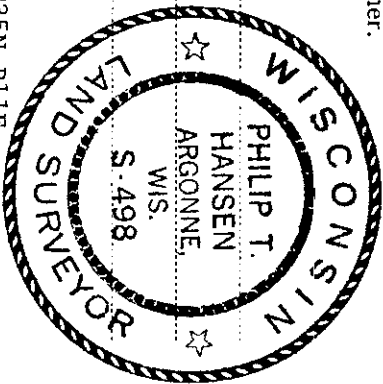

○ = Corner monument restored.

History of original corner establishment:

Original corner established by unknown source. Corner re-established by H.C. Lawrence, Registered Land Surveyor, in 1959 during his retracement survey. He states he ran the section line between Section 13-35-11 and Section 18-35-12 south 4°00'E from the intersection of center line of North-South and East-West road, which he assumed to be the Section Corner, 80.50 chains to center line of road west. At 40.26 chains he recovered a fence line east and two old scribed posts east and west of highway. At 20.12 he found an old scribed post set in rocks, 20 links south of old fence running east. Set a 3" cedar post surrounded by carron of rocks.

Description of corner evidence found:

Recovered old 3" cedar post, squared and scribed N-1/16 S13, N-1/16 S18, surrounded by rock carron in very poor condition. A 1-1/2" iron pipe had been set beside it.

No OBT's were recovered.

Description of monument and accessories I established to perpetuate the original location of this corner.

Replaced wooden stake with 1-1/2" OD iron pipe w/2" brass cap stamped -

NBT's: Sugar 12" N76°E 62 links scribed 1/16BT
 Sugar 11" S59°E 44 links scribed 1/16BT

R11E S13 | S18 R12E
 T35N
 CPI-1975

Dated at Rhineland Wis, this 4th day of June, 19 75.

Signature Philip T. Hansen Title Registered Land Surveyor Registration No. S-498
 (County Surveyor, Registered Land Surveyor, or other duly authorized official)

Office of Registrar of Deeds, County of Oneida I hereby certify that the within instrument was filed in this office for record on the 1st day of October 19 75 at 3:00 o'clock P. M.

Doris Verage Fuchler
 (Register of Deeds)

By _____ Deputy

35 11 13 3000