

CERTIFIED LAND CORNER RESTORATION

Index No. K-21

State of Wisconsin



County of Oneida } ss.

I, Phillip T. Hansen, do hereby certify that on the 5th day of May, 1977, I found evidence of the N 1/16 corner of Section 13 & 14 Township 35 North, Range 11 East, Fourth Principal Meridian, as described hereon; and that from this evidence I established a new monument and accessories as described hereon to perpetuate the original location of this corner.

Resident witnesses:

Jim Claflin

Herb Wagoner

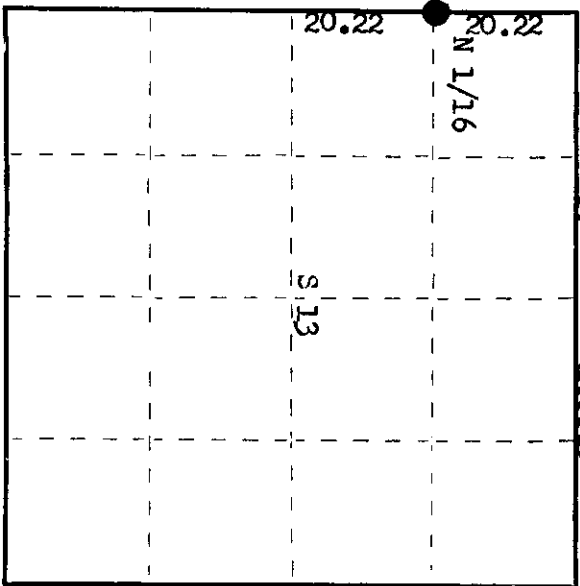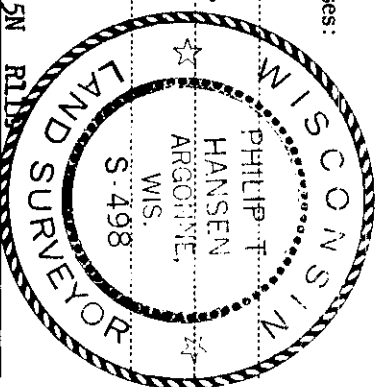

○ = Corner monument restored.

History of original corner establishment:

Original Corner established by D.H. Vaughan, County Surveyor. Corner re-established by H.C. Lawrence, Registered Land Surveyor, in 1959. He ran a random line south from Section Corner 11, 12, 13, 14, 40.44 chains to close out 6 links west of 1/4 corner between 13 & 14. Set 6" squared and scribed post on line at 20.22 chains. This lined up with centerline of highway west. No trees near for BTs.

Description of corner evidence found:

Recovered 6" squared cedar post lying on the ground with rock cairn at base.  
Recovered point of post in center of cairn.  
No BTs recovered.

Description of monument and accessories I established to perpetuate the original location of this corner.

Set a 1" iron pipe 24" long in old post hole, flush with ground.  
Set a 1" iron pipe with 2" brass cap, 50 links south of true corner for Witness Corner.  
W. Monument projects 22" above ground. Cap stamped:  
NBT - White Birch 6" S46°W, 59.7 links, scribed 1/16 BT.

T35N R11E  
S14°S13  
N 1/16  
N 50.0 lks.  
S498-1977

Dated at Rhineland, Wis., this 13th day of May, 1977.

Signature Phillip T. Hansen Title Registered Land Surveyor Registration No. S-498  
(County Surveyor, Registered Land Surveyor, or other duly authorized official)

Office of Register of Deeds, County of Oneida  
at 10:30 o'clock A. M. 16th day of May, 1977.  
I hereby certify that the within

Doris Vearge Kuehn  
(Register of Deeds)

By..... Deputy

35-11143600