

CERTIFIED LAND CORNER RESTORATION



Index No. **N-13**

State of Wisconsin }  
 County of Oneida } ss.

I, Phillip T. Hansen, 15th day of July, 1976, I found evidence of the section corner of 15, 16, 21 and 22 Township 35, North, Range 11 East, Fourth Principal Meridian, as described hereon; and that from this evidence I established a new monument and accessories as described hereon to perpetuate the original location of this corner.

Resident witnesses:

Glen Barker  
Jim Claffin  
Herb Wagoner

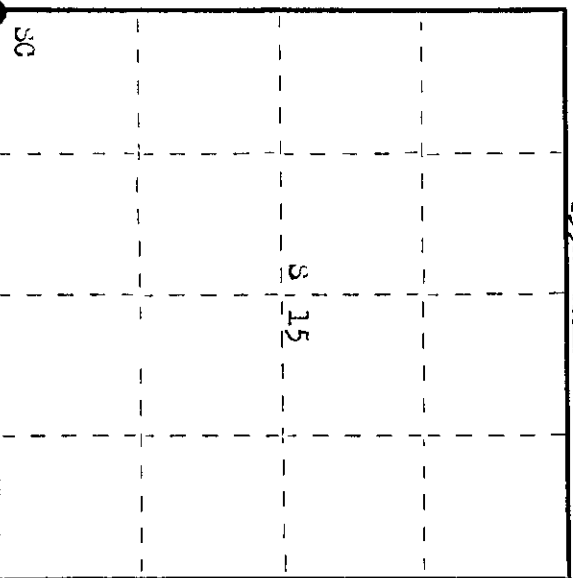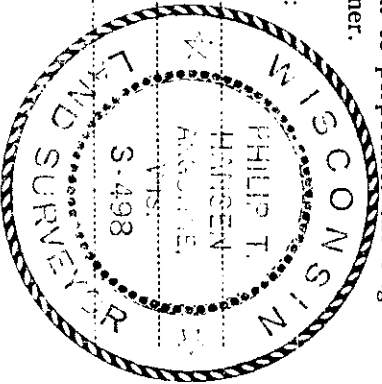

○ = Corner monument restored.

History of original corner establishment: Original Corner established by Wm. W. Dougherty, Deputy Surveyor, in 1859, from which Fir 10" bears S 56° 0' 0" W 9 lks and Fir 10" bears N 45° 0' 0" W 8 lks. Corner re-established by H.C. Lawrence, Registered Land Surveyor, from sight of ray map of Q&W Rd. from lile post 3, thence north 580 on centerline of railroad 92 lks, thence north 3.91 chains to Corner. set cedar post, no BTs. Lawrence stated he found a small stake 31 lks east and 31 lks north of the corner he established. This was a 1 1/2" squared stake, setting in crevice of natural rock pile (not manmade). He did not accept this stake as it did not check out to calls on old Rd map. He also found corner stakes in the vicinity poorly assumed.

Description of corner evidence found:  
 Recovered 4" cedar post, squared and scribed 15, 16, 21, 22 in poor condition.  
 Recovered a 1/2" x 2 ft. iron pipe at post mentioned above 31 lks north and 03 lks east.  
 The 4" cedar post checked out to 3.91 chains north of centerline of old Rd grade.

Description of monument and accessories I established to perpetuate the original location of this corner.  
 Replaced 4" cedar with 2 1/2" iron pipe with brass cap stamped.  
 Monument projects 2 1/2 ft. above ground.  
 Placed large rock cairn around base.  
MBTs - Maple 8" S 23° 0' 0" W 66.3 lks, scribed 30 BT.  
Maple 7" S 19° 0' 0" W 09.0 lks, scribed 30 BT.  
Birch 10" N 30° 0' 0" E 29.3 lks, scribed 30 BT.  
 Monument and BTs painted blue.

S-498  
T35N R11E  
16 15  
21 22  
sec.  
CPT-1976

Dated at Rhineland, Wis., this 19th day of August, 1976.

Signature Phillip T. Hansen Title Registered Land Surveyor Registration No. S-498  
 (County Surveyor, Registered Land Surveyor, or other duly authorized official)

Office of Register of Deeds, County of Oneida  
 instrument was filed in this office for record on the 23rd day of September, 1976  
 at 10:00 o'clock M. hereby certify that the within

Doris Therese Fischer  
 (Register of Deeds)

By \_\_\_\_\_ Deputy

351160006