

CERTIFIED LAND CORNER RESTORATION

Index No. N-9

State of Wisconsin



County of Oneida } ss.

I Phillip T. Hansen, do hereby certify that on the 4th day of May, 1978, I found evidence of the Section corner of Sections 16, 17, 20, 21 Township 35, North, Range 11 East, Fourth Principal Meridian, as described hereon; and that from this evidence I established a new monument and accessories as described hereon to perpetuate the original location of this corner.

Resident witnesses:

Jim Clafflin

Herb Wagoner

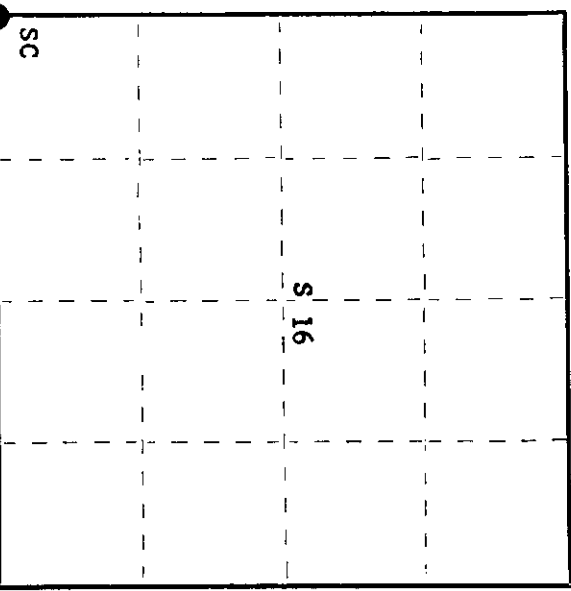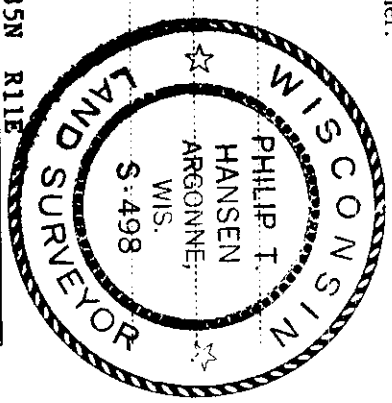

○ = Corner monument restored.

History of original corner establishment:

Original corner established by Wm. E. Dougherty, Deputy Surveyor, in 1859, from which tamarack 6" bears S74°E, 4 links and tamarack 6" bears N36°W, 16 links. H.C. Lawrence, Registered Land Surveyor, set this corner in 1953. Ran west from south 1/4 corner section 16 to where fence turned south, extended this line west at 43.63, squared a 5" tamarack which was 73.18 chains south of original corner 8, 9, 16, 17.

Description of corner evidence found:

Recovered Lawrence's 5" square cedar post, scribed S16, S17, S20, S21, which sets next to an 8" squared tamarack standing green. No evidence or records of any old BT's.

Description of monument and accessories I established to perpetuate the original location of this corner.

- Replaced Lawrence's post with 2 1/2" Bertensen A-1 Federal Monument projecting 16" above ground. Cap stamped:
- Marked NBT's - White Birch 8" N4°E, 122.5 ft. T35N R11E
- White Pine 16" S8°E, 93.2 ft. SC 17, 16
- Maple 7" S15°W, 73.7 ft. SC 20, 21
- Tamarack east, 1.45 ft., S498-1978
- all scribed BT.

Dated at Rhineland, Wis., this 7th day of May, 1978.

Signature Phillip T. Hansen Title Registered Land Surveyor Registration No. S-498
(County Surveyor, Registered Land Surveyor, or other duly authorized official)

Office of Register of Deeds, County of Oneida
Instrument was filed in this office for record on the 15th day of May, 1978
at 2:00 o'clock P. M. I hereby certify that the within

Bonnie Cleavage Kuehn
(Register of Deeds)

By: Gregory M. Boerner Deputy

351170660