

CERTIFIED LAND CORNER RESTORATION

Index No. L-9

State of Wisconsin



County of Oneida } ss.

I, Phillip T. Hansen, do hereby certify that on the 15th day of May, 1978, I ~~restored~~ established the Quarter corner of Sections 16 & 17

Township 35, North, Range 11 East, Fourth Principal Meridian, as described hereon; and that from this evidence I established a new monument and accessories as described hereon to perpetuate the original location of this corner.

Resident witnesses:

Glen Barker  
Jim Claflin  
Herb Wagoner

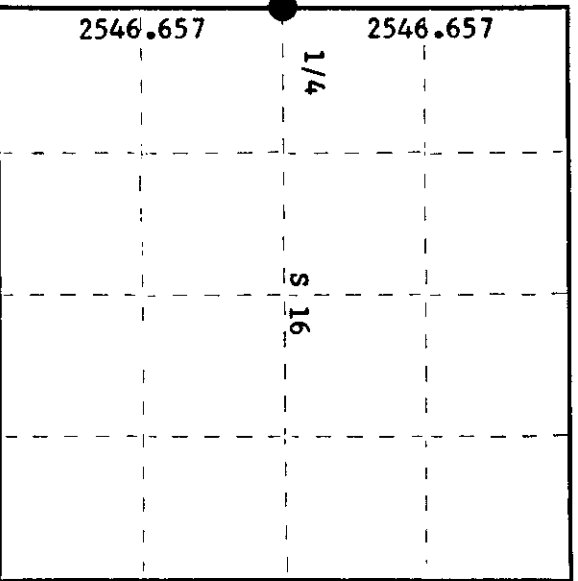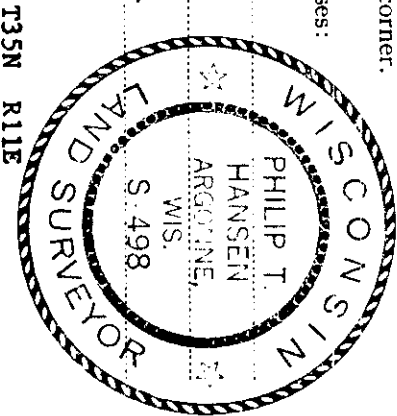

○ = Corner monument restored.

History of original corner establishment:

Original corner established by Wm. E. Dougherty, Deputy Surveyor, in 1859 from which white birch 12" bears S56°W, 30 links and white birch 10" bears N32°E, 30 links.

No records of any subsequent survey. In 1953 H.C. Lawrence, Registered Land Surveyor, ran a line from section corner 8, 9, 16 and 17, original corner, south to section corner 16, 17, 21 & 20, but was unable to locate any 1/4 corner and no records of any corner set.

Description of corner evidence found:

No evidence of any corner recovered. Corner established by traverse and computation. Ran traverse from previously established section corner 8, 9, 16 & 17 to section corner 16, 17, 20, 21. Computed distance 5093.313 feet at bearing S 1° 29' 45" E. Set 1/4 corner at 2546.657 feet intermediate.

Description of monument and accessories I established to perpetuate the original location of this corner.

Set 2 1/2" Bernitsen A-1 Federal Monument (O.C.). Cap stamped:

Placed large rock cairn around base of monument.

Marked NBT's -  
Maple 8" N57°W, 20.12 feet  
Sugar 8" N41°E, 13.45 feet  
Sugar 6" S89°E, 14.96 feet  
Sugar 6" S3°W, 15.76 feet  
all scribed 1/4 BT.

Dated at Rhineland, Wis., this 30th day of May, 1978

Signature Phillip T. Hansen Title Registered Land Surveyor Registration No. S-498  
(County Surveyor, Registered Land Surveyor, or other duly authorized official)

Office of Register of Deeds, County of Oneida, I hereby certify that the within instrument was filed in this office for record on the 13th day of June, 1978 at 2:30 o'clock P. M.

Tara Savage Kuhl  
(Register of Deeds)

By Joseph M. Borman Deputy

351172000