

CERTIFIED LAND CORNER RESTORATION

Index No. K-9

State of Wisconsin }
County of Oneida } ss.

History of original corner establishment:


No records of any previous survey.

I Phillip T. Hansen, do hereby certify that on the 15th day of May, 1978, I ~~found~~ established the N 1/16 corner of Section 16 & 17 Township 35, North, Range 11 East, Fourth Principal Meridian, as described hereon; and that from this evidence I established a new monument and accessories as described hereon to perpetuate the original location of this corner.

Description of corner evidence found:
No evidence of any corner recovered.
Corner established by traverse and computation, computed distance 2546.657 feet from 1/4 corner to section corner 8, 9, 16 and 17 at bearing N 1° 29' 45" W. Set N 1/16 at 1273.329 feet intermediate.


Resident witnesses:

Glen Barker
Jim Clafflin
Herb Wagoner

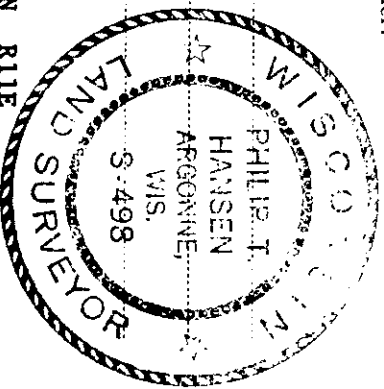

Description of monument and accessories I established to perpetuate the original location of this corner:
Set 1 1/2" iron pipe with 2" brass cap, projecting 24" above ground, cap stamped:

Marked NBT's -
Sugar 7" N50°E, 44.15 feet
Sugar 6" N72°W, 7.50 feet, scribed 1/16 BT.
T35N R11E
N 1/16 17 + 16
CPI-1978

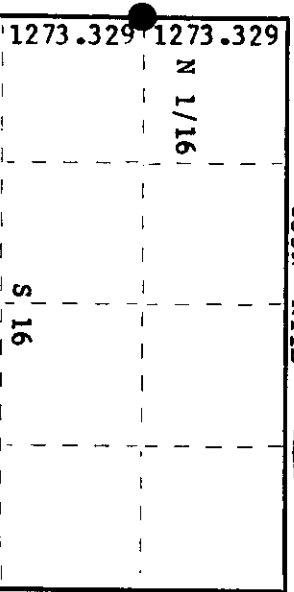

○ = Corner monument restored.

Dated at Rhineland, Wis., this 30th day of May, 19 78

Signature Phillip T. Hansen Title Registered Land Surveyor Registration No. S-498
(County Surveyor, Registered Land Surveyor, or other duly authorized official)

Office of Register of Deeds, County of Oneida
Instrument was filed in this office for record on the 13th day of June, 1978 at 2:30 o'clock P. M. I hereby certify that the within

Jean Bergey Kuehn
(Register of Deeds)

By: Joseph M. Barner Deputy

3511173000