

CERTIFIED LAND CORNER RESTORATION

Index No. M-5

State of Wisconsin


County of Waushara } ss.

I Philip T. Hanson, do hereby certify that on the 6th day of October, 1979, I found evidence of the 1/16 corner of Section 17 - 18 Township 35 North, Range 11 East, Fourth Principal Meridian, as described hereon; and that from this evidence I established a new monument and accessories as described hereon to perpetuate the original location of this corner.

Resident witnesses:

Alex Barkon

Herb Johnson

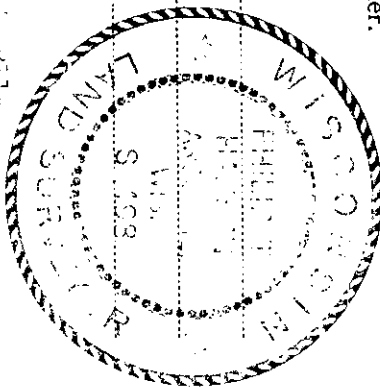


History of original corner establishment: Corner established by H.C. Lawrence, registered land surveyor, in 1953. He ran a zinc line of 37' 0" from established 1/4 corner. It 20.00 links to found on old line, surveyed, 40 links west of its random line, at 20.00 he closed out 2 links east at right angles. He set his 1/16 at 19.29 chains equivalent 44 links west. The old stake he found was close to line north and south, but was 77 links too far south.
 Corner 30" 60° 48 links

Description of corner evidence found:

Recovered 4" cedar post, surveyed and scribbled 1/16 on, 2 1/2 to 3 1/2 in fair condition. Recovered 1/2" - 1/4" iron pipe, 20° to 30° angle, recovered 1/16 on. Corner 6" (7") 50° (60°) 48 links, scribbled 1/16 on.

Description of monument and accessories I established to perpetuate the original location of this corner. Replaced cedar post with 1" 1/2 iron pipe with 2" brass cap stamped: monument projects 4" above ground. no additional accessories established.

122-111
 10/6/79
 31-1-1979

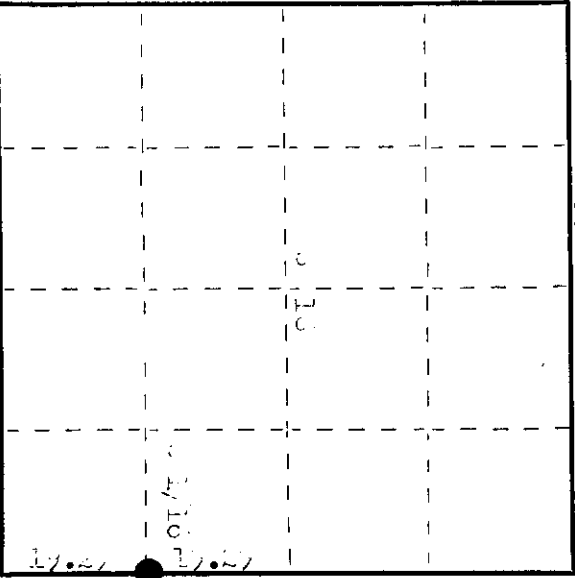

○ = Corner monument restored.

Dated at Waushara, Wis. this 23rd day of October, 1979.

Signature: Philip T. Hanson Title: Registered Land Surveyor Registration No. 122-111
 (County Surveyor, Registered Land Surveyor, or other duly authorized official)

Office of Register of Deeds, County of Waushara. I hereby certify that the within instrument was filed in this office for record on the 7th day of December, 1976 at 11:50 o'clock P. M.

Dana Terape Kuehn
 (Register of Deeds)

By: Joseph M. Bernum Deputy