


CERTIFIED LAND CORNER RESTORATION


Index No. K-5

State of Wisconsin }
 County of Oneida } ss.

I Philip T. Hansen, do hereby certify that on the 21st day of May 1975, I found evidence of the N-1/16 corner of Section 17 and 18 Township 11 E, North, Range 35, Fourth Principal Meridian, as described hereon; and that from this evidence I established a new monument and accessories as described hereon to perpetuate the original location of this corner.

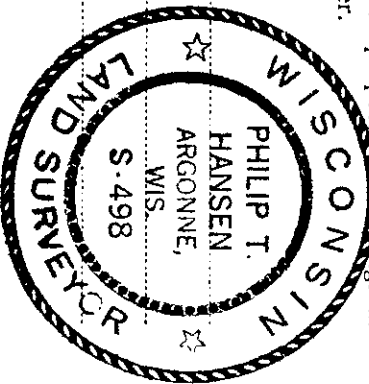

Resident witnesses.

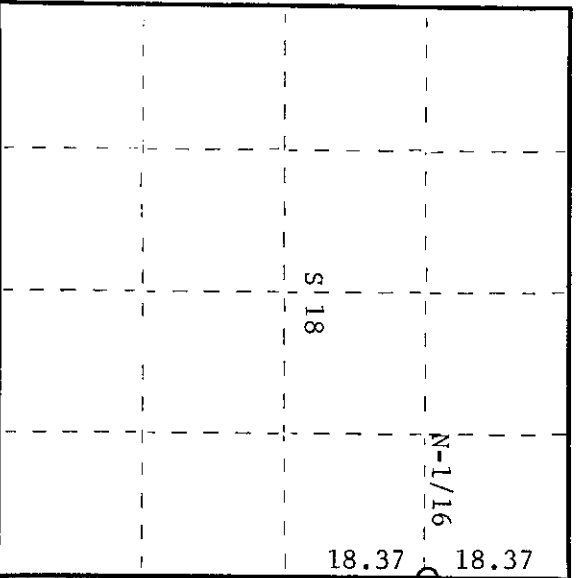

○ = Corner monument restored.

History of original corner establishment:

Corner established by H.C. Lawrence, Registered Land Surveyor, during his retracement survey in 1953. He measured along the cleared out fence line from the 1/4 corner N3-1/2°W(Mag.) a distance of 36.74 chains to an iron pipe set at Section Corner S7-S8-S17-S18. Set a 5" hemlock post equidistant at 18.37 chains in fence line from which sugar maple 14" bears S80°W, 38-1/2 links and sugar maple 7" bears S75°E, 19 links.

Description of corner evidence found:

Recovered 5" hemlock post, squared and scribed N-1/16 S17, N-1/16 S18 in good condition.

Recovered OBT's: Sugar 14"(16) S80°W(S84°W) 38.5 links scribed N-1/16 S18 BE
 Sugar 7"(10) S75°E 19 links scribe grown over

Description of monument and accessories I established to perpetuate the original location of this corner.

Replaced wood stake with 1-1/2 OD iron pipe w/2" brass cap stamped -

S498
 T37N R11E
 N-1/16 S18 | S17
 CPI-1975

Dated at Rhineland, Wis., this 6th day of June, 1975.

Signature: *Philip T. Hansen* Title: Registered Land Surveyor Registration No. S-498
 County Surveyor, Registered Land Surveyor, or other duly authorized official

Office of Register of Deeds, County of Oneida
 Instrument was filed in this office for record on the 1st day of October, 1975 at 3:00 o'clock P.M.

Donna Verage Kuehn
 (Register of Deeds)

By: _____ Deputy

35 11 18 3000