

CERTIFIED LAND CORNER RESTORATION



Index No. **R-5**

State of Wisconsin } ss.
County of Oneida

I Philip T. Hansen, do hereby certify that on the 16th day of April 19 75 I found evidence of the section corner corner of Sec. 19-20-29-30 Township 11 E, North, Range 35, Fourth Principal Meridian,

as described hereon; and that from this evidence I established a new monument and accessories as described hereon to perpetuate the original location of this corner.

Resident witnesses:

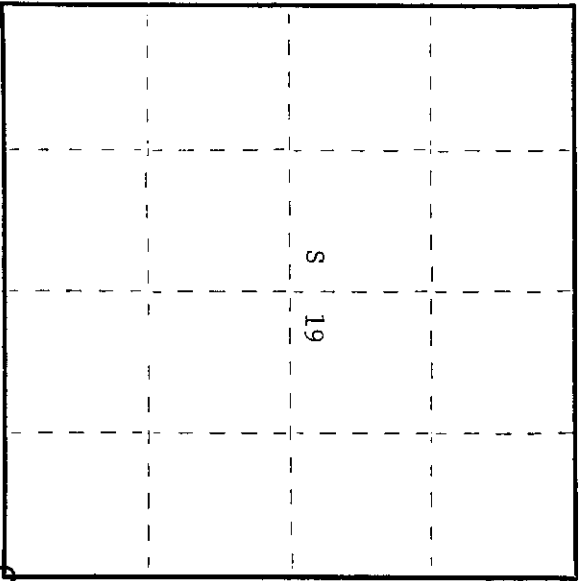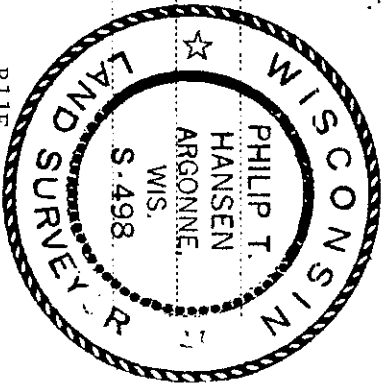

○ = Corner monument restored.

History of original corner establishment:

Original corner established by Wm. E. Dougherty, Gov. Deputy Surveyor, in 1859. Tamarack 8" bears S62°W 46 links and Tamarack 8" bears S45°E 8 links. Corner recovered by D.H. Vaughan, County Surveyor, in 1906, who claims to have found the original BT's. Corner recovered by H.C. Lawrence, Reg. Land Surveyor, found an iron pipe with brass cap. Several old posts and a new wooden post which he had placed there several years prior.

Description of corner evidence found:

Recovered a 2-1/2" iron pipe w/brass cap but not stamped. Also recovered a 3" Tamarack post, squared but not scribed, broken off and in poor condition. No old BT's were recovered.

Description of monument and accessories I established to perpetuate the original location of this corner.

Stamped iron pipe with brass cap.

NBR's - Black Spruce 5' N52°W 76.3 links scribed SC BT T35N R11E
Red Pine 7" N6°E 210 links scribed SC BT S498



CPI-1975

Dated at Rhineland, Wis. this 28th day of April, 19 75

Signature: *Philip T. Hansen* Title: Reg. Land Surveyor Registration No. S-498
(County Surveyor, Registered Land Surveyor, or other duly authorized official)

Office of Register of Deeds, County of Oneida. I hereby certify that the within instrument was filed in this office for record on the 1st day of October 19 75 at 3:00 o'clock P.M.

Dorcas Terage Kuehn
(Register of Deeds)

By: Deputy

3511190000