
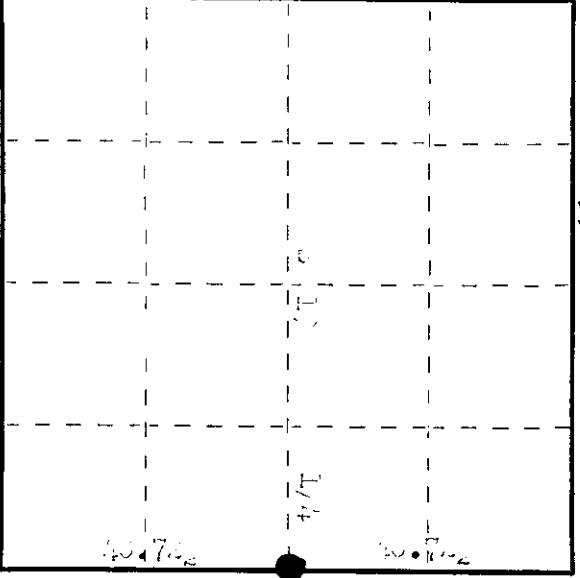


CERTIFIED LAND CORNER RESTORATION

Index No. P-5

State of Wisconsin } ss.  


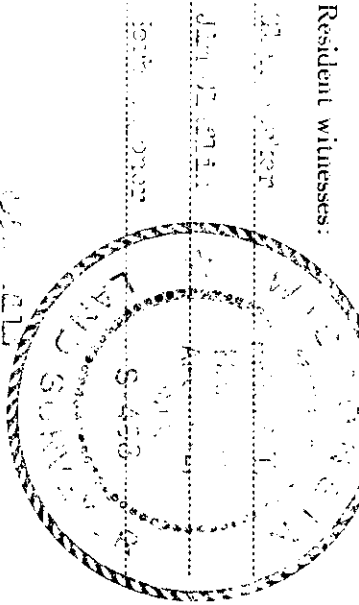

○ = Corner monument restored.








351192000