

State of Wisconsin

County of Waushara } ss.




Resident witnesses:

Alvin Larson

Jim Martin

hereafter

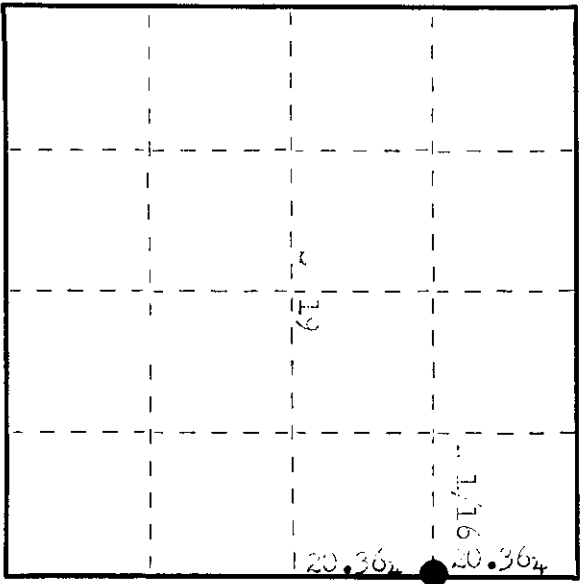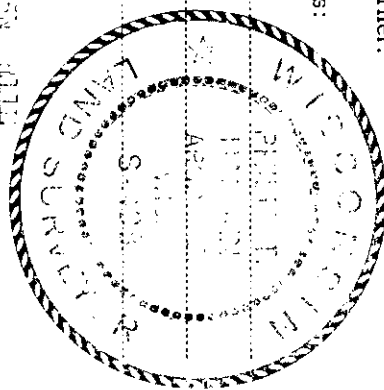

○ = Corner monument restored.



Description of corner evidence found:

recovered Hansen's 4" corner post, squared and scribed 1/16 day, in 1/16 and in poor condition. Also recovered Hansen's original joint and his pins.

Description of monument and accessories I established to perpetuate the original location of this corner:



Signature Pauline M. Hansen Title County Surveyor Registration No. 2-478

Office of Register of Deeds, County of Waushara at 7:25 o'clock P.M. I hereby certify that the within instrument was filed in this office for record on the 7th day of March, 1976.

By Joseph M. Borman Deputy (Register of Deeds)