

CERTIFIED LAND CORNER RESTORATION

Index No. **R-9**

State of Wisconsin


County of Oneida } ss.

History of original corner establishment:
Original corner established by Wm. E. Dougherty in 1859. Maple 7", S34°E, 11 links; fir 10", N42°W, 11 links.

I Philip T. Hansen, do hereby certify that on the 16th day of April, 1975, I found evidence of the Section Corner corner of S20, 21, 28, 29 Township 35 North, Range 11 East, Fourth Principal Meridian, as described hereon; and that from this evidence I established a new monument and accessories as described hereon to perpetuate the original location of this corner.

Corner reestablished by H.C. Lawrence, Registered Land Surveyor in 1953. While running line east from Corner Sec. 19-20-29-30 at N88°E, recovered someone's squared white birch at 40.00 chains, 2.45 chains North at right angles and someone's old stake at 82.30, 6.36 chains North at right angles. Corrected bearing of line N83°25'E. Set 4" cedar post.

Resident witnesses:

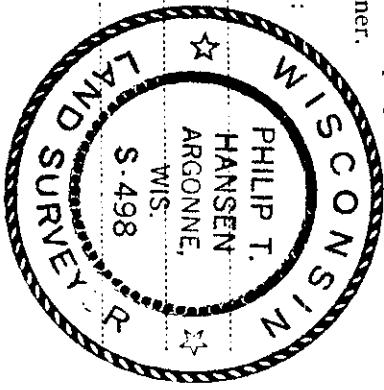


Description of corner evidence found:
Recovered Lawrence's 4" squared cedar post, scribed S20, S21, S28, S29 in poor condition. Also, someone's 1-1/2" iron pipe and an old squared cedar post.
No BT's visible.

Description of monument and accessories I established to perpetuate the original location of this corner.
Replaced Lawrence's squared and scribed cedar post, a 1-1/2" iron pipe with 2-1/2" galvanized iron pipe with brass cap stamped -

NBT's - White spruce 7" S31°W 40.6 links scribed SC BT
White birch 7" N63°W 69.7 links scribed SC BT

S498
T35N R11E
S20 S21
S29 S28
CPI-1975

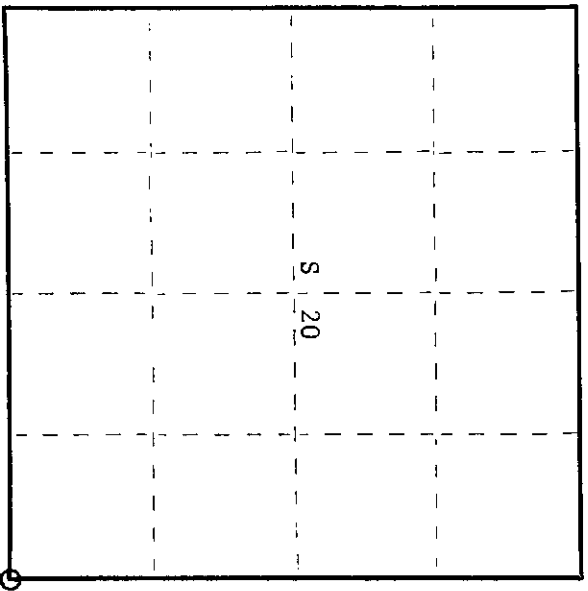

Dated at Rhinelander, Wis., this 6th day of May, 1975

Signature: *Philip T. Hansen* Title: Registered Land Surveyor Registration No. S-498
(County Surveyor, Registered Land Surveyor, or other duly authorized official)

Office of Register of Deeds, County of Oneida
Instrument was filed in this office for record on the 1st day of October, 1975 at 3:00 o'clock P.M.

Dona Terence Fischer
(Register of Deeds)

By: Deputy

3511200000