CERTIFIED LAND CORNER RESTORATION

Index No. R-6

State of Wisconsin
County of Oneida } ss.

I Philip T. Hansen, do hereby certify that on the 18th day of July, 19 78, I ~~found~~ established ~~xxxxxxxx~~ the W 1/16 corner of Section 20 & 29 Township 35, North, Range 11 East, Fourth Principal Meridian, as described hereon; and that from this evidence I established a new monument and accessories as described hereon to perpetuate the original location of this corner.

Resident witnesses:

Glen Barker

Jim Claflin

Herb Wagoner

John Masbaum

WISCONSIN PHILIP T. HANSEN ARGONNE, WIS. S-498 LAND SURVEYOR

T35N R11E

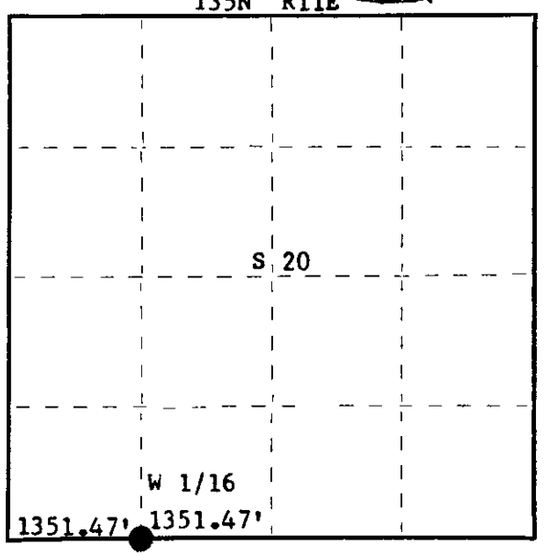

○ = Corner monument restored.

History of original corner establishment:

H.C. Lawrence ran the line between sections 20 & 29 in 1953. Set temporary posts for W 1/16 with no bt's as his tie to the section corner (wood post) was questionable.

Description of corner evidence found:

No evidence of any corner recovered.
Corner established by traverse and computation. From previous established 1/4 corner computed distance to section corner 19, 20, 29 & 30 was 2702.94 feet at bearing S 89° 03' 02' W.
Set W 1/16 at 1351.47 feet intermediate.

Description of monument and accessories I established to perpetuate the original location of this corner.

Set 1½" iron pipe with 2" brass cap for W 1/16 corner projecting 24" above ground.

Cap stamped:
S498
T35N R11E
W 1/16 S 20 / S 29
CPI-1978

Marked NBT's -
Maple 8" N70°W, 31.08 feet
Maple 6" S55°W, 39.67 feet, all scribed 1/16 BT.

Dated at Rhinelander, Wis., this 26th day of July, 19 78.

Signature Philip T. Hansen Title Registered Land Surveyor Registration No. S-498
(County Surveyor, Registered Land Surveyor, or other duly authorized official)

Office of Register of Deeds, County of Oneida, I hereby certify that the within instrument was filed in this office for record on the 21st day of August, 1978 at 10 o'clock P M.

Doris Verage Kuehn
(Register of Deeds)

By ..... Deputy

FORM 985 H. C. MILLER CO., MILWAUKEE

35/1200030