

CERTIFIED LAND CORNER RESTORATION

Index No. R-12



State of Wisconsin }  
County of Oneida } ss.

I Phillip T. Hansen, do hereby certify that on the 22nd day of May, 1978, I ~~restored~~ re-established the E 1/16 corner of Sections 21 & 28 Township 35, North, Range 11 East, Fourth Principal Meridian,

as described hereon; and that from this evidence I established a new monument and accessories as described hereon to perpetuate the original location of this corner.

Resident witnesses:

Glen Barker  
Jim Clefflin  
Herb Wagoner

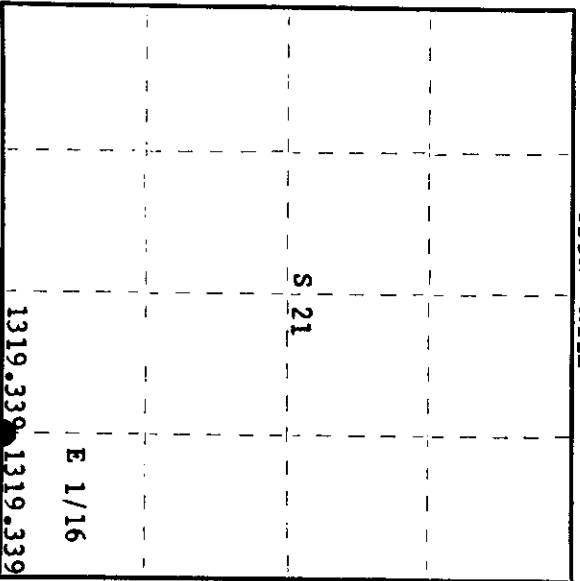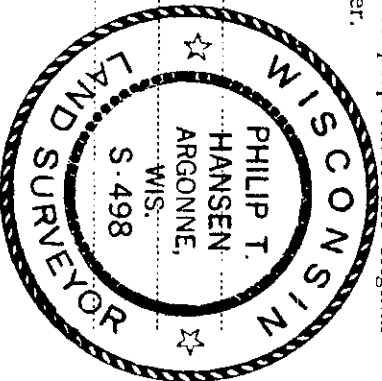

○ = Corner monument restored.

History of original corner establishment:  
**No records of any previous survey.**

Description of corner evidence found:

**No evidence of any corner recovered. Corner established by single proportion from traverse and computation. Ran traverse from previously established 1/4 corner to recovered section corner 21, 22, 27 and 28. Computed distance 2638.677 feet at bearing N 88° 01' 13" W. Set E 1/16 at 1319.389 feet intermediate.**

Description of monument and accessories I established to perpetuate the original location of this corner.

**Set 1 1/2" iron pipe with 2" brass cap projecting 2 1/4", stamped:  
Placed large rock cairn around base of monument.  
Marked NBT's - Maple 6" S28°W, 14.63 feet T35N R11E  
Maple 6" N81°W, 29.75 feet E 1/16 S 21  
scribed 1/16 BR. CPI-1978**

Dated at Rhinelander, Wis., this 5th day of June, 1978.

Signature Phillip T. Hansen Title Registered Land Surveyor Registration No. S-498  
(County Surveyor, Registered Land Surveyor, or other duly authorized official)

Office of Register of Deeds, County of Oneida  
at 11:35 o'clock A. M. 26th day of June, 1978  
I hereby certify that the within

Terri Venge Fuchs  
(Register of Deeds)

By: \_\_\_\_\_ Deputy

3511210010