

CERTIFIED LAND CORNER RESTORATION

Index No. P-11

State of Wisconsin } ss.
County of Oneida

History of original corner establishment:
No records of any previous survey.

I, Phillip T. Hansen, do hereby certify that on the 23rd day of May, 1978, I ~~restored~~ **established** the C 1/4 corner of Section 21 Township 35, North, Range 11 East, Fourth Principal Meridian, as described hereon; and that from this evidence I established a new monument and accessories as described hereon to perpetuate the original location of this corner.


Description of corner evidence found:

No evidence of any C 1/4 corner recovered.

Corner established by traverse & computation. Ran traverse from N 1/4 corner to S 1/4 corner previously established and from W 1/4 corner to E 1/4 corner previously established to determine the C 1/4 corner which lies S 0° 01' 27" E of N 1/4 corner of computed distance of 2614.899 feet. Corner fell in east lane of Stockley-Melster Road. Distance to S 1/4 corner is 2562.691 feet.

Resident witnesses:

Glen Barker
Jim Clafflin
Herb Wagoner

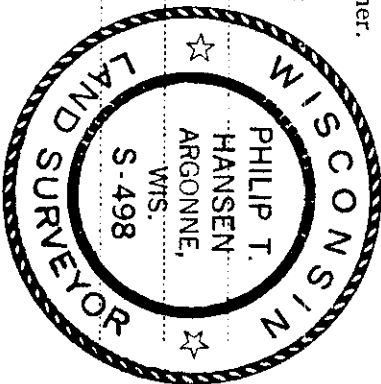

Description of monument and accessories I established to perpetuate the original location of this corner.

Set a 1 1/2" x 18" iron pipe in east lane of Stockley-Melster Road for true corner, 5" below the surface of road.

Set a 2 1/2" Berntsen A-1 Federal Monument (CPI) 40' west of iron pipe for a witness corner. Cap stamped:

Monument projects 24" above ground.
Marked NBT's - Red Pine 9" N24°E, 80.25 feet T35N R11E
Red Pine 10" N60°E, 39.70 feet C 1/4 S 21 W.C.
White Spruce 6" S31°E, 55.65 feet
Measurements made to true corner. All scribed C 1/4 BR. E. 40 ft. to Cor. S498-1978


Dated at Rhinelander, Wis., this 5th day of June, 1978

Signature: Phillip T. Hansen Title: Registered Land Surveyor Registration No. S-498
(County Surveyor, Registered Land Surveyor, or other duly authorized official)

Office of Register of Deeds, County of Oneida, I hereby certify that the within instrument was filed in this office for record on the 13th day of June, 1978 at 2:30 o'clock M.

Susan Savage Kuehl
(Register of Deeds)

By: Joseph M. Barner Deputy

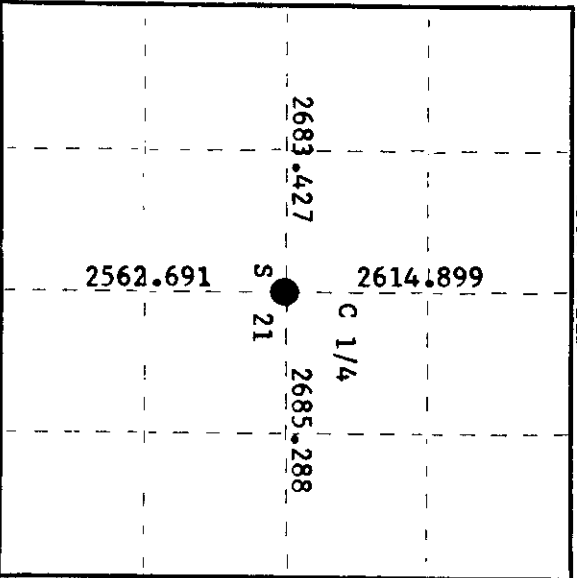

○ = Corner monument restored.