

CERTIFIED LAND CORNER RESTORATION


Index No. **P-10**

State of Wisconsin }  
 County of Oneida } ss.

History of original corner establishment:  
**No evidence of any corner found.**

I Phillip T. Hansen, do hereby certify that on the 9th day of June, 1978, I ~~found~~ **established** the W.C. 1/16 corner of Section 21 Township 35, North, Range 11 East, Fourth Principal Meridian, as described hereon; and that from this evidence I established a new monument and accessories as described hereon to perpetuate the original location of this corner.


Description of corner evidence found:  
**Corner established by traverse and computation from W 1/4 section 21 to C 1/4 corner. Computed distance is 2683.427 feet at bearing S 89° 16' 10" E. Set W.C. 1/16 at 1341.714 feet intermediate.**

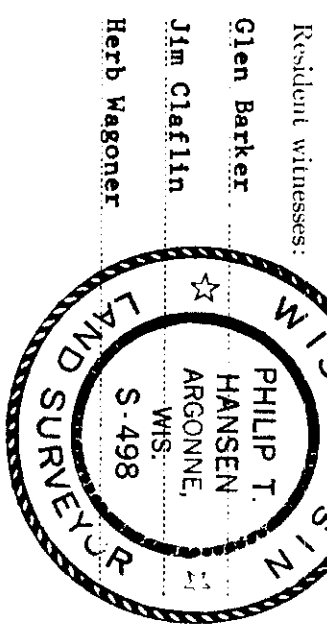

Resident witnesses:  
 Glen Barker  
 Jim Claflin  
 Herb Wagoner

Description of monument and accessories I established to perpetuate the original location of this corner.  
**Set a 1 1/2" iron pipe with 2" brass cap, stamped:  
 Pipe projects 18" above ground.  
 Marked NBT's -  
 Tamarack 4" N47°W, 30.66 feet  
 Tamarack 8" S17°E, 48.38 feet  
 scribed 1/16 BT**

S498  
 T35N R11E  
 WC 1/16 S+21  
 CPI 1978

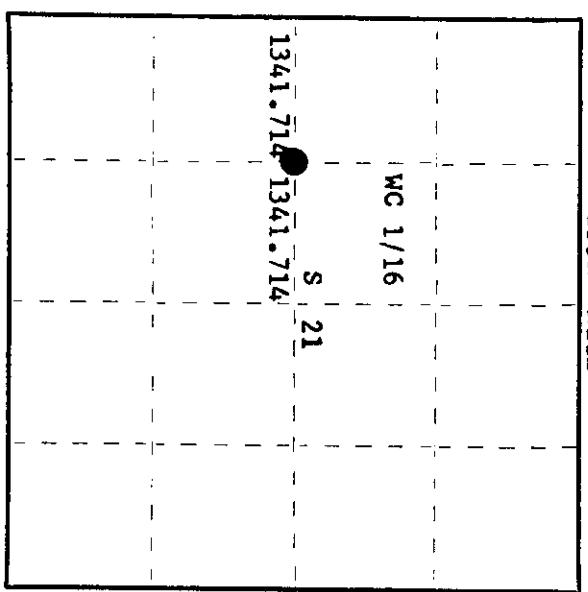

○ = Corner monument restored.

Dated at Rhinelander, Wis., this 10th day of July, 1978.

Signature: Phillip T. Hansen Title: Registered Land Surveyor Registration No. S-498  
 (County Surveyor, Registered Land Surveyor, or other duly authorized official)  
 Office of Register of Deeds, County of Oneida, I hereby certify that the within instrument was filed in this office for record on the 17th day of July, 1978 at 10:00 o'clock A. M.

Dorcas Leverage Fuchs  
 (Register of Deeds)

By: \_\_\_\_\_ Deputy

2511212030