

CERTIFIED LAND CORNER RESTORATION


Index No. 0-11

State of Wisconsin }
County of Oneida } ss.

I, Phillip T. Hansen, do hereby certify that on the 23rd day of May, 1978, I ~~restored~~ re-established the NC 1/16 corner of Section 21 Township 35, North, Range 11 East, Fourth Principal Meridian, as described hereon; and that from this evidence I established a new monument and accessories as described hereon to perpetuate the original location of this corner.

Resident witnesses:

Glen Barker
Jim Clafflin
Herb Wagoner

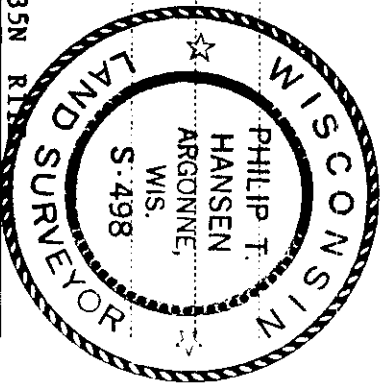


History of original corner establishment:

No record of any previous survey.

Description of corner evidence found:
No evidence of any corner recovered.
Corner established by traverse and computation. Ran E-W & N-S 1/4 lines from previously established 1/4 corners to establish C 1/4 corner. C 1/4 corner computed at 2614.90 ft. S 0° 01' 27" W of N 1/4 corner. Corner set at 1307.45 feet Intermediate.

Description of monument and accessories I established to perpetuate the original location of this corner.
Set a 1 1/2" x 18" iron pipe in west lane of Stockley - Melster Road for true corner, 5" below the surface of road.
Set a 1 1/2" iron pipe with 2" brass cap 37 feet east of true corner for witness corner.
Monument projects 24" above ground. Cap stamped:
Marked NBT's to true corner -
White Spruce 7" N69°E, 47.12 ft. S498 T35N R11E
White Spruce 7" S46°W, 61.15 feet, scribed 1/16 BT NC 1/16 S 21 W.C.C.

W - 37 ft.
CPI-1978

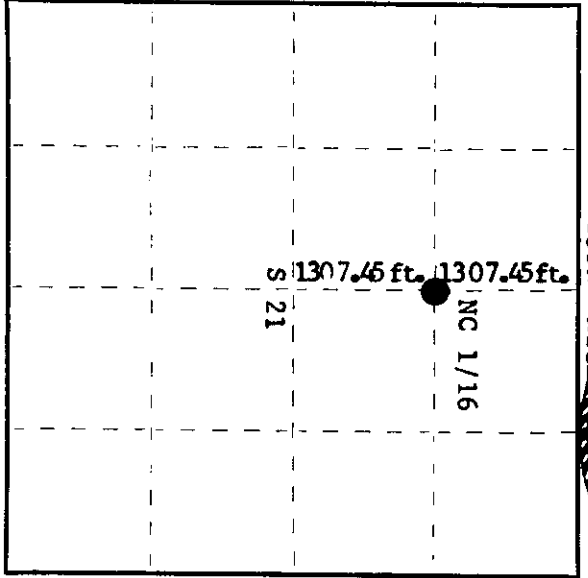

○ = Corner monument restored.

Dated at Rhinelander, Wis., this 5th day of June, 1978.
Signature: Phillip T. Hansen Title: Registered Land Surveyor Registration No. S-498
(County Surveyor, Registered Land Surveyor, or other duly authorized official)

Office of Register of Deeds, County of Oneida.
Instrument was filed in this office for record on the 26th day of June, 1978 at 11:35 o'clock a. M.

Donna Verage Tucker
(Register of Deeds)

By: _____ Deputy

3511213020