



U.S. PUBLIC LAND SURVEY MONUMENT RECORD

Note: This form is intended and designed to fulfill all requirements of Wisconsin Administrative Code, Chapter A-E 7.08 U.S. Public Land Survey Monument Record (3) (a) (b) (c) (d) (e) (f) (g) (h) (i). An additional sheet may be added if necessary to conform with said requirements.

(a) Corner location: Township 35 North
 Range 11 East ~~West~~

Town/City/Village SCHOEPKE

County ONEIDA

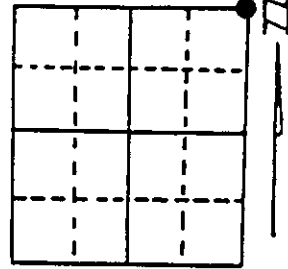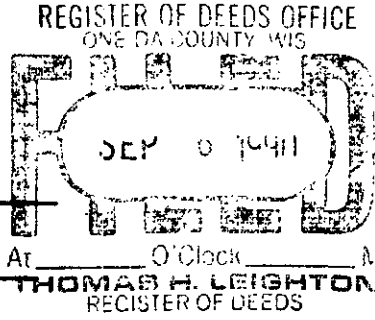


Section 26

(b) (f) (g) (h) Description of monument found at this corner and if it was accepted, state all evidence (material, testimonial, occupational, plats, records, other monuments) used as a basis for accepting. If not accepted or if nothing was found, state evidence used as basis for establishing location. If reestablished through lost corner proportionate methods, indicate all monuments, distances and directions used to establish. Indicate type of monument found or set and sign post.

1859, W. DAUGHERTY ESTABLISHED ORIGINAL CORNER
 1914, D. H. VAUGHAN DROVE IRON PIN 1/2" x 15" IN ROAD FOR POST
 BT'S - 12" SUGAR, N 69 1/2 E, 104 1/2"
 10" " N 77 1/2 E, 79 1/2"
 JUNE 6, 1990, W. F. KELLY FOUND IRON IN E OF HWY. Z. SET R/R SPIKE OVER IRON & SET 3" AL. WITNESS MONUMENT EAST OF CORNER.

(c) (d) (e) Plan view of corner with ties to at least 4 witness monuments. If in disagreement with previously established corner, show the distances between the two corners and also indicate the ties to the disputed corner.

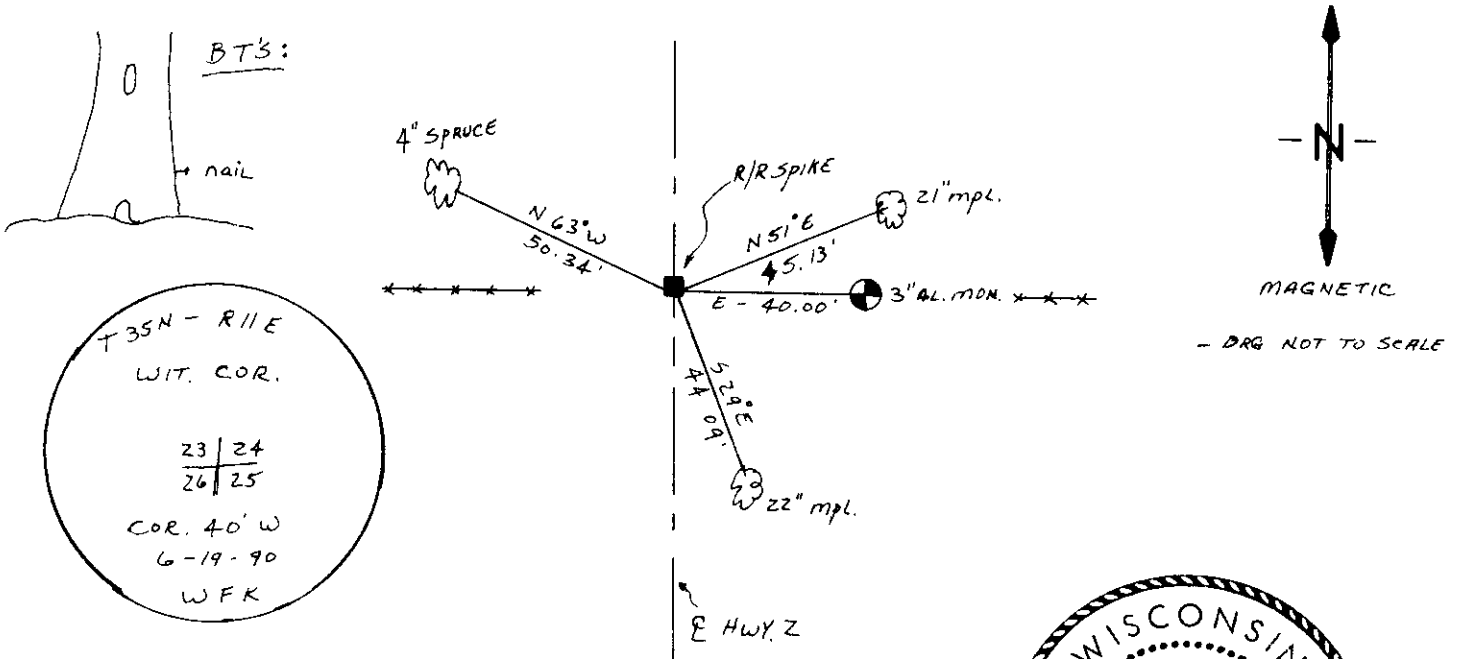

(i) I, WILLIAM F. KELLY
 (type or print name) certify that the corner location on this record was determined by me or under my direction and control and that this U.S. Public Land Survey Monument Record is correct and complete to the best of my knowledge and belief.



Index No. R-21

William F. Kelly 8-28-90
 Signature Date

Stamp
 3511230000