

CERTIFIED LAND CORNER RESTORATION



Index No. R-24

State of Wisconsin }
 County of Oneida } ss.

I Phillip T. Hanson, do hereby certify that on the 12th day of November, 1976, I found evidence of the E 1/16 corner of Section 24, T. 25 Township 35, North, Range 11 East, Fourth Principal Meridian, as described hereon; and that from this evidence I established a new monument and accessories as described hereon to perpetuate the original location of this corner.

Resident witnesses:

Allen Barber
Jim Olsfin
Herb Swanner

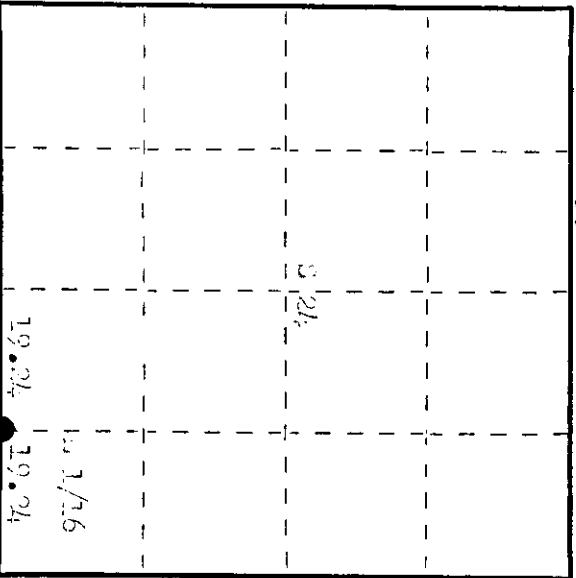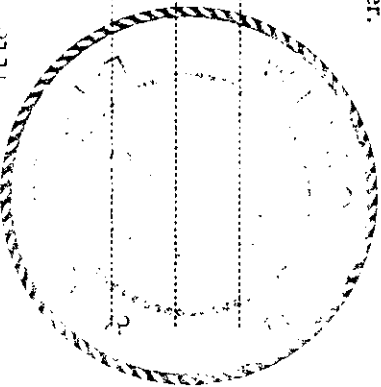

○ = Corner monument restored.

History of original corner establishment:

Corner established by H.C. Lyrrance, Registered Land Surveyor, in 1852. Original monument line west from section corner 24-25 - 19, 30, 38, 43 on pins to close out 4.43 chains north of 1/4 corner. Set 3" cedar post 2.21 chains south at 19.24 chains intermediate. Marked 187 - 24 14" x 61" E 75 links, Ironwood 9" x 74" x 64 links.

Description of corner evidence found:

Recovered 3" cedar post, squared and scribed E 1/16 24, E 1/16 25. 1" rock cairn around base. Post was in fair condition.
 Recovered 187 - 24 14" x 61" x 75 links, scribed 224 27.
 Ironwood 9" x 74" x 64 links, scribed 225 27.

Description of monument and accessories I established to perpetuate the original location of this corner.

Replaced with 1" iron pipe with 2" brass cap stamped:
 Monument projects 24" above ground.
 Placed a rock cairn around base of monument.
 187 - 24 14" x 61" x 75 links, scribed 1/16 27.
 T35 R11E
 E 1/16 24
 224 27
 225 27
 U-1-1976

Dated at Oneida, Wis., this 1st day of December, 1976.

Signature Phillip T. Hanson Title Registered Land Surveyor Registration No. 2-498
 County Surveyor, Registered Land Surveyor, or other duly authorized official

Office of Register of Deeds, County of Oneida
 Instrument was filed in this office for record on the 9th day of December, 1976
 at 2:05 o'clock M. I hereby certify that the within

Dana Savage Kueh
 (Register of Deeds)

By: Joseph M. Barner Deputy

3511240010