

CERTIFIED LAND CORNER RESTORATION



Index No. R-23

State of Wisconsin }

I Phillip M. Hansen, do hereby
 certify that on the 11th day
 of November, 1976, I found
 evidence of the marker
 corner of section 24, 3, 25
11 East, Fourth Principal Meridian,
 as described hereon; and that from this evidence
 I established a new monument and accessories
 as described hereon to perpetuate the original
 location of this corner.

Resident witnesses:

Glen Barker
Jim Martin
Harb A. Omer

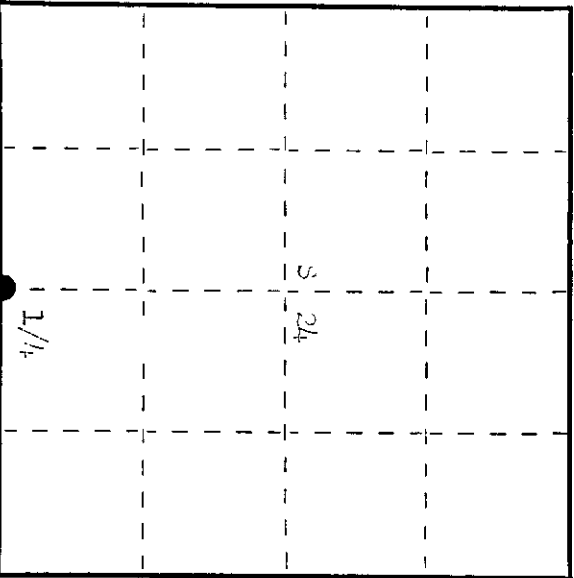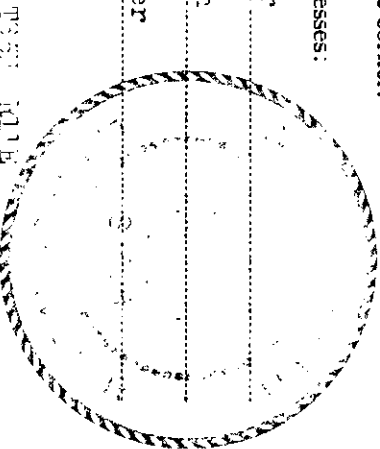

○ = Corner monument restored.

History of original corner establishment:

Original corner established by Wm. E. Dougherty, Deputy Surveyor, in 1859, from a line
 white spruce 100' bears S 88° W 32 links and Birch 30' bears S 79° W 41 links. Corner
 recovered by D.M. Vaughn, County Surveyor, in 1907, recovered original W.T.
H.C. Lawrence, registered Land Surveyor, ran a random line west from section corner 24,
 25, 19, 30 and at 38.43 chains closed out 4.43 chains north of 1/4 corner.
 Set a 3" cedar post and marked white ash 11" S 35° W 15 links and white ash 11" S 42° W

Description of corner evidence found:

Recovered a 3" cedar post, squared and scribed 1/4" 24, 1/4" 25 in fair condition.
 Corner sets in an old 1-2 fence line.
 Recovered W.T. - white ash 14" S 27° W 30 links, scribed 1/4" 24.
H.C. Lawrence - white ash 14" S 35° W 15.5 links, scribed 1/4" 25. Visible.

Description of monument and accessories I established to perpetuate the original location of this corner.

Replaced cedar post with 2 1/2" diameter - 1" aluminum monument, aluminum with magnet
 in cap and base. 31, scribed:
 Monument projects 10" above ground.
W.T. - Black ash 14" S 27° W 30 links, scribed 1/4" 24.
H.C. Lawrence - Black ash 14" S 35° W 15.5 links, scribed 1/4" 25.
 Block as 10" S 27° W 30 links, scribed 1/4" 24.
 T35N R11E
 1/4 24
 1/4 25
 3488-1975


Signature Phillip M. Hansen Title Registered Land Surveyor Registration No. 4498
 (County Surveyor Registered Land Surveyor, or other duly authorized official)

Office of Register of Deeds, County of Ozaukee
 Instrument was filed in this office for record on the 9th day of December, 1976
 at 2:05 o'clock P.M. I hereby certify that the within

By Marie Leverage Tuck (Register of Deeds)
Joseph M. Barner Deputy