

CERTIFIED LAND CORNER RESTORATION



Index No. 0-23

State of Wisconsin }
County of Oneida } ss.

I Phillip S. Hansen, do hereby certify that on the 11th day of November, 1976, I found evidence of the 10 1/4 corner of the Section 24 Township 35, North, Range 11 East, Fourth Principal Meridian, as described hereon; and that from this evidence I established a new monument and accessories as described hereon to perpetuate the original location of this corner.

Resident witnesses:

Glen Sawyer
Herb Macomber

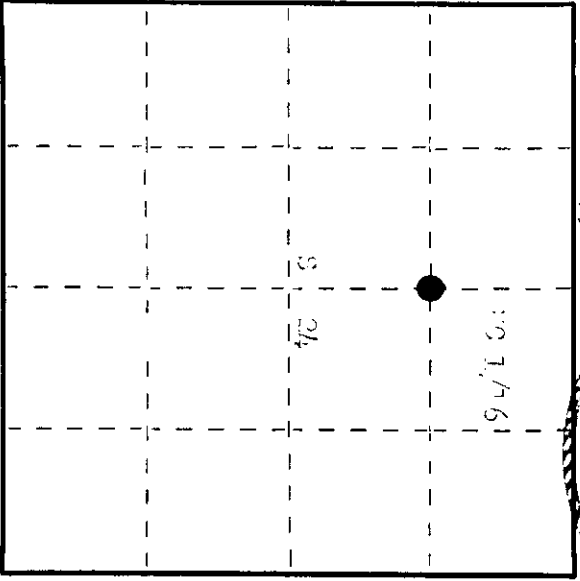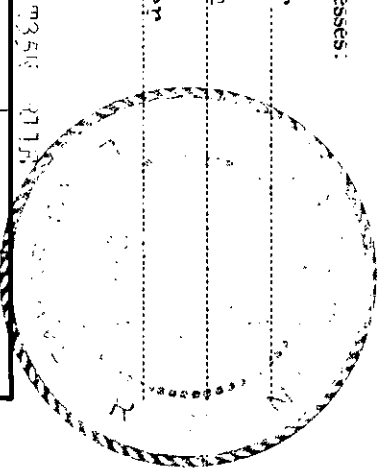

○ = Corner monument restored.

History of original corner establishment:


Description of corner evidence found:




3498
1935
1976
GPI-1975

Dated at Oneida, Wis., this 1st day of December, 1976

Signature Phillip S. Hansen Title County Surveyor, Registered Land Surveyor, or other duly authorized official Registration No. 2409
(County Surveyor, Registered Land Surveyor, or other duly authorized official)

Office of Register of Deeds, County of Oneida. I hereby certify that the within instrument was filed in this office for record on the 9th day of December, 1976 at 2:05 o'clock P.M.

By Doris Neugebauer (Register of Deeds)
Joseph M. Bremer Deputy

351243020