

CERTIFIED LAND CORNER RESTORATION

Index No. **U-25**

State of Wisconsin





Resident witnesses:

Allen Meyer

John Martin

Temp. corner

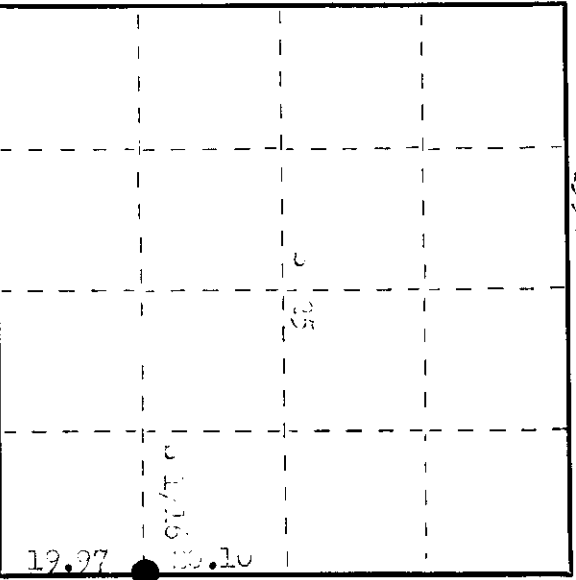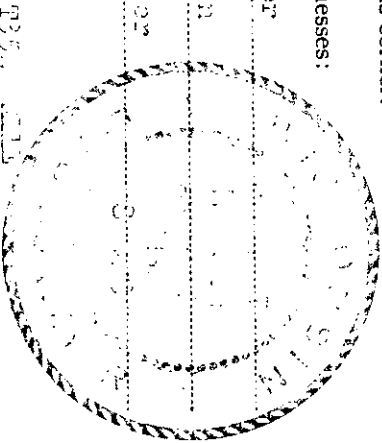

O = Corner monument restored.

History of original corner establishment:









498
132
11 22 30 12
CPL-1976





3511251000