

CERTIFIED LAND CORNER RESTORATION

Index No. U-23

State of Wisconsin

County of Oneida } ss.

I Phillip T. Hansen, do hereby

certify that on the 16th day

of November, 1976, I found

evidence of the SC 1/16

corner of Section 25

Township 35, North, Range


11 East, Fourth Principal Meridian,

as described hereon; and that from this evidence

I established a new monument and accessories

as described hereon to perpetuate the original

location of this corner.

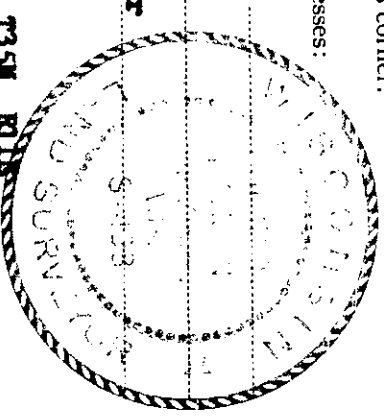


Resident witnesses:

Glen Barker

Jim Carlton

Herb Wagener

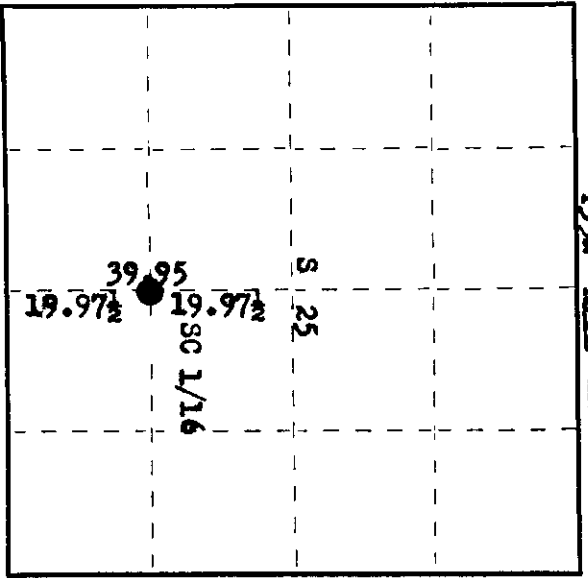

○ = Corner monument restored.

History of original corner establishment:

Corner established by H.C. Lawrence, Registered Land Surveyor, in 1958.

Ran a random line, he ran south (mag.) 81.26 chains to intersect Section Line 1.62 chains east of 1/4 corner. Ran E-W 1/4 line and established C 1/4 corner at 41.31 chains south of W 1/4. Set SC 1/16 at 61.28 chains south intermediate between C 1/4 and S 1/4 and 1.22 chains west. Marked cedar 16" due east 20 links and Yellow Birch 16" S 30° W 37 links. A creek is 22 links east of post.

Description of corner evidence found:

Recovered 6" cedar post, squared and scribed SC 1/16 S25, SC 1/16 S25 in good condition, with rock cairn around base.

Recovered cedar 16" (18") due east 20 links, scribed S25 BT.

Yellow Birch 16" (18") S 30° W (S 34° W) 37 links, scribed S 1/16 BT.

Description of monument and accessories I established to perpetuate the original location of this corner.

Replaced 6" wood post with 1 1/2" OD iron pipe with brass cap stamped:

Monument projects 18" above ground. S498
T35N R11E

NBT - Cedar 8" S 67° E 39.2 links, scribed 1/16 BT. SC 1/16 S 125

Replaced rock cairn around base of monument. CPI-1976

Dated at Rhineland, Wis., this 3rd day of December, 1976

Signature Phillip T. Hansen Title Registered Land Surveyor Registration No. 5498
(County Surveyor, Registered Land Surveyor, or other duly authorized official)

Office of Register of Deeds, County of Oneida 20th day of December, 1976
I hereby certify that the within instrument was filed in this office for record on the 19th day of December, 1976
at 1:05 o'clock P. M.

Louis Vinage Fisher
(Register of Deeds)

By: _____ Deputy

3511251020