


State of Wisconsin } ss.
County of **Oneida**



Township **35**, North, Range **11**, Fourth Principal Meridian, as described hereon; and that from this evidence I established a new monument and accessories as described hereon to perpetuate the original location of this corner.

Resident witnesses:

- Glen Barker**
- Jlm Clarlin**
- Herb Wagoner**

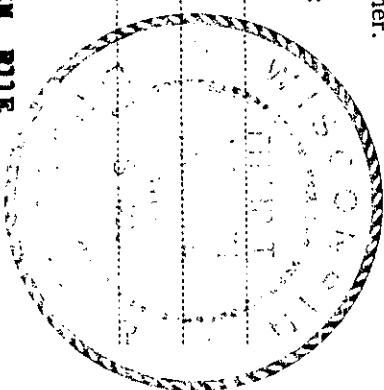

T35N R11E

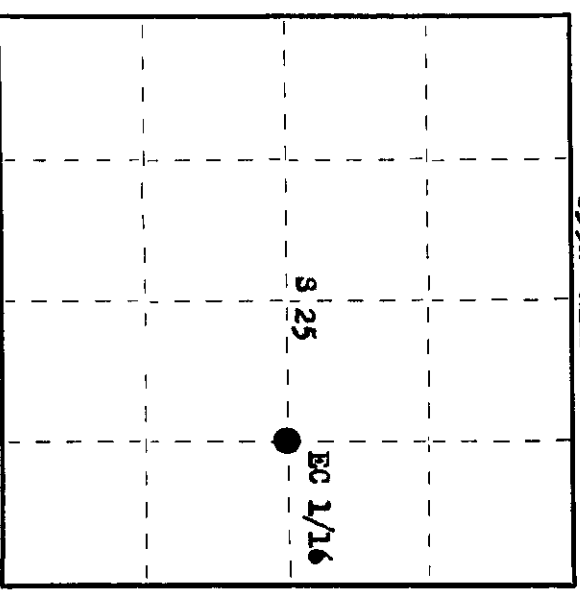

○ = Corner monument restored.

History of original corner establishment:

Corner established by H.C. Lawrence, Registered Land Surveyor, in 1958. Ran the N-S and E-W 1/4 line to establish the C 1/4 corner. Established C 1/4 corner at 39.60 chains west of E 1/4 corner. Set EC 1/16 at 19.80 chains equidistant. Marked MBTs - White Spruce 20" S 50° W 41 1/2 links and Sugar 14" N 30° E 32 links.

Description of corner evidence found:

Recovered 4" cedar post, squared and scribed EC 1/16 S25, EC 1/16 S25 with rock cairn around base in fair condition.
Recovered MBTs - White Spruce 20" S 50° W (S 54° W) 41.5 links, scribed S25 BT (now dead). Sugar 14" (16") N 30° E 32 links, scribed EC 1/16 BT.

Description of monument and accessories I established to perpetuate the original location of this corner.

Replaced 4" cedar post with 1 1/2" OD iron pipe with 2" brass cap stamped:
Monument projects 2 1/2" above ground.
MBT - Sugar 6" S 32° E 10.9 links, scribed 1/16 BT.
Replaced rock cairn around base of monument.

3498
T35N R11E
EC 1/16 S 25
CPI-1976

Dated at **Rhineland**, Wis., this **3rd** day of **December**, 19**76**

Signature *Phillip T. Hansen* Title **Registered Land Surveyor** Registration No. **S-498**
(County Surveyor, Registered Land Surveyor, or other duly authorized official)

Office of Register of Deeds, County of **Oneida** I hereby certify that the within instrument was filed in this office for record on the **30th** day of **December**, 19**76** at **1:00** o'clock **P**. M.

Laine Perge Kricha
(Register of Deeds)

By: _____ Deputy

351125 0010