CERTIFIED LAND CORNER RESTORATION

Index No. T-23

State of Wisconsin
County of Oneida } ss.

I Philip T. Hansen, do hereby certify that on the 15th day of November, 19 76, I found evidence of the C 1/4 corner of Section 25 Township 35, North, Range 11 East, Fourth Principal Meridian, as described hereon; and that from this evidence I established a new monument and accessories as described hereon to perpetuate the original location of this corner.

Resident witnesses:

Glen Barker

Jim Claflin

Herb [illegible]

T35N R11E

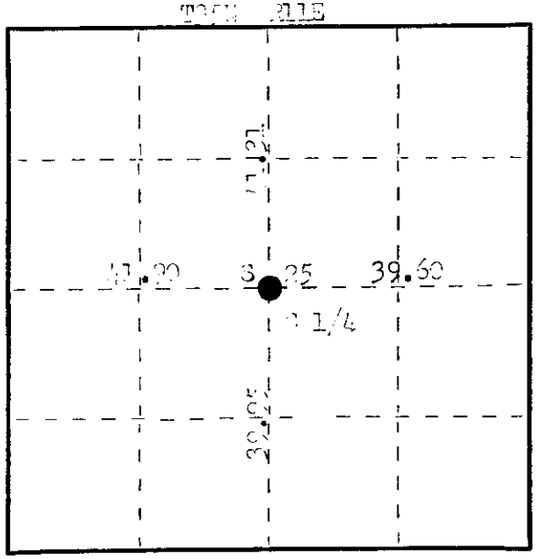

O = Corner monument restored.

History of original corner establishment:

Corner established by H.C. Lawrence, Registered Land Surveyor, by running the S 1/4 line and E-W 1/4 line. Correcting and setting post at 41.31 chains south of C 1/4 corner and marked BTs - Hemlock 12" 35° 36 links, White Ash 12" 40° 30 links.

Description of corner evidence found:

Recovered 5" cedar post, squared and scribed C 1/4 S25, C 1/4 S25 in fair condition. Rock cairn around base of post.
Recovered BT - Hemlock 12" (13") 35° 36 links, scribed C 1/4 BT.
White Ash 12" (16") 40° 30 links, scribing partly visible.

Description of monument and accessories I established to perpetuate the original location of this corner.

Replaced with 2½" iron pipe with brass cap set equal:
Replaced rock cairn around base.
Monument projects 21" above ground.
BT - Maple 12" 45° 42 links, scribed C 1/4 BT.

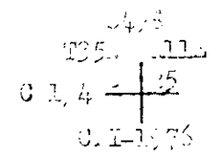

Dated at Rhinelander, Wis., this 2nd day of December, 19 76.

Signature Philip T. Hansen Title Registered Land Surveyor Registration No. S-1992
(County Surveyor, Registered Land Surveyor, or other duly authorized official)

Office of Register of Deeds, County of Oneida, I hereby certify that the within instrument was filed in this office for record on the 20th day of December, 19 76 at 1:00 o'clock P. M.

Doris Verage Kuehn
(Register of Deeds)

By ..... Deputy

FORM 985 H C MILLER CO., MILWAUKEE

35112S02E