

CERTIFIED LAND CORNER RESTORATION

Index No. **7-22**

History of original corner establishment:

Corner established by H.C. Lawrence, Registered Land Surveyor, in 1958. Ran the E-W 1/4 line and N-S 1/4 line to establish the C 1/4 corner. Determined distance from C 1/4 to W 1/4 at 41.90 chains. Set WC 1/16 at 20.95 chains equidistant. Set 3" cedar post and marked Yellow Birch 16" S 65° W 33½ links and black cherry 12" S 58° E 8 links.

Description of corner evidence found:

Recovered 3" cedar post, squared and scribed WC 1/16 S25 WC 1/16 S25 with rock cairn around base of monument. Monument in fair condition.

Recovered OBTS - Yellow Birch 16" (18") S 65° W (S 72° W) 33.5 links, scribed WC 1/16 BT. Black Cherry 12" S 58° E (S 48° E) 8 links, scribed S25 BT.

Description of monument and accessories I established to perpetuate the original location of this corner.

Replaced cedar post with 1½" iron pipe with 2" brass cap stamped: Monument projects 24" above ground.

NBTs - Sugar 10" S 2° W 23.1 links  
 Sugar 9" N 36° E 47.3 links, scribed 1/16 BT.  
 WC 1/16 S 25  
 T35N R11E  
 S498  
 CPL-1976

State of Wisconsin

County of Oneida } ss.



I, Philip T. Rhineland, do hereby certify that on the 15th day of November, 1976, I found evidence of the WC 1/16 corner of the Section 25 Township 35, North, Range 11 East, Fourth Principal Meridian, as described hereon; and that from this evidence I established a new monument and accessories as described hereon to perpetuate the original location of this corner.

Resident witnesses:

Glen Barker

Jim Clark

Herb Wagoner

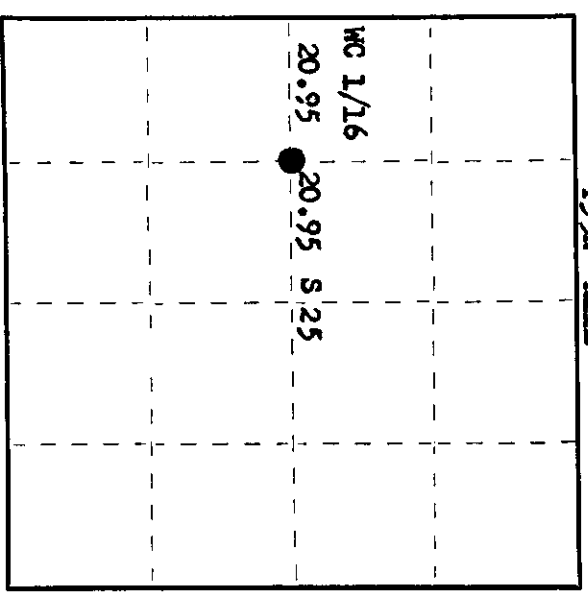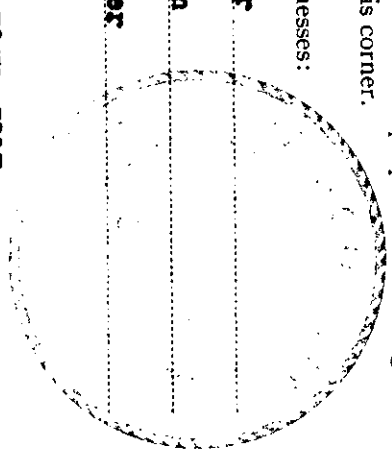

○ = Corner monument restored.

Dated at Rhineland, Wis., this 2nd day of December, 1976

Signature Philip T. Rhineland Title Registered Land Surveyor Registration No. S-498  
 (County Surveyor, Registered Land Surveyor, or other duly authorized official)

Office of Register of Deeds, County of Oneida  
 instrument was filed in this office for record on the 20th day of December, 1976  
 at 1:00 o'clock P. M.

James Leverage Bush  
 (Register of Deeds)

By: \_\_\_\_\_ Deputy

0300251153