

CERTIFIED LAND CORNER RESTORATION

Index No. **S-23**

State of Wisconsin

County of Oneida } ss.



I William T. Hansen, do hereby certify that on the 15th day of November, 1976, I found evidence of the NO 1/16 corner of Section 25 Township 35, North, Range 11 East, Fourth Principal Meridian, as described hereon; and that from this evidence I established a new monument and accessories as described hereon to perpetuate the original location of this corner.

Resident witnesses:

Glen Barker

Jim Maflin

Herb Masoner

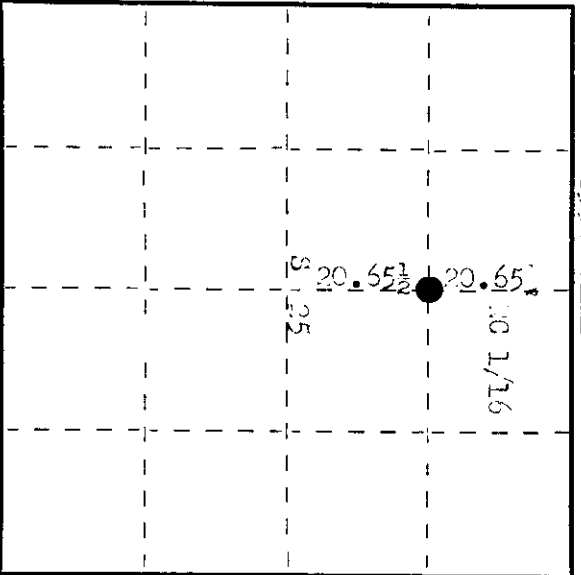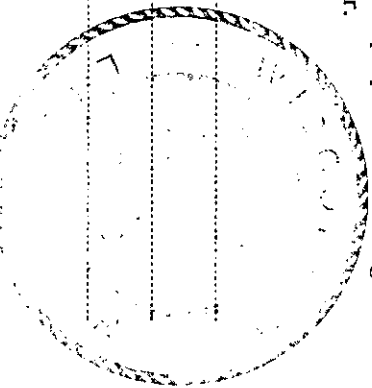

○ = Corner monument restored.

History of original corner establishment:

Corner re-established by H.O. Lawrence, registered land surveyor, in 1958. Ran NO 1/4 line and NO 1/4 line to establish the NO 1/4 corner, established NO 1/16 at 20.65 chains equidistant. Set post and marked PPts - Sugar 124 S 70° NO 1/16 and Sugar 164 S 25° NO 1/16 links.

Description of corner evidence found:

Recovered 7 1/2 cedar post, squared and scribed NO 1/16 NO 1/16 and NO 1/16 with rock cairn around base. Post in fair condition. Recovered PPts - Sugar 124 S 70° NO 1/16 and Sugar 164 S 25° NO 1/16 links.

Description of monument and accessories I established to perpetuate the original location of this corner.

Replaced cedar post with 1 1/2 inch iron pipe with 2 1/2 inch brass cap, set on 2 1/2 inch monument projects 4 1/2 above ground. PPt - Sugar 124 S 70° NO 1/16 links, scribed NO 1/16 NO 1/16. Replaced rock cairn around base of monument.

20.65
T35. ALLI
NO 1/16 25
NO 1/16 25
011-1975

Dated at Oneida, Wis., this 1st day of December, 1976.

Signature Willard Starnawal Title Registered Land Surveyor Registration No. 2-198
(County Surveyor, Registered Land Surveyor, or other duly authorized official)

Office of Register of Deeds, County of Oneida. I hereby certify that the within instrument was filed in this office for record on the 9th day of December, 1976 at 2:00 o'clock P. M.

Steve Savage Tusk
(Register of Deeds)

By Joseph M. Barner Deputy

3511253020