

CERTIFIED LAND CORNER RESTORATION

State of Wisconsin }
 County of Oneida } ss.

I, Philip T. Hansen do hereby certify that on the 29th day of August 1975, I found evidence of the Quarter corner of Section 26 and 35 Township 35 North Range 11 East Fourth Principal Meridian, as described hereon; and that from this evidence I established a new monument and accessories as described hereon to perpetuate the original location of this corner:

Description of original monument and accessories and subsequent restorations: Original corner established by Wm. E. Dougherty, Gov. Deputy Surveyor in 1859, from which Hemlock 11" bears S76° W 14 lks, and Hemlock 10" bears N 81° E 18 lks. Corner recovered and restored by D.H. Vaughan 1914. Set well point from which Y.Pine 10" bears West 40½ lks. Corner recovered by H.C. Lawrence, Reg. Land Surveyor, 1959. Set new 5" cedar post beside Vaughan's well point and marked, NB^Ts - N.Pine 10" N 15°E 50 lks and Oak 9" N 60°W 54½ lks. No trace remaining of Vaughan's Y.Pine BT

Description of corner evidence found: Recovered 5" wooden post, squared and scribed ¼ S S 26, ¼ S S 35 with rock carron around it, in poor condition. Recovered well point, fair condition in ground beside wooden post.


Recovered ^UBT R.Pine 10" (12") N 15°E (N17°E) 50 lks scribed ¼ S 26 BT
 R.Oak 9" (10") N 60°W (N58°W) 54.5 lks scribing grown over

Description of monument and accessories I established to perpetuate the location of this corner:

Replaced well point with 2½" iron pipe with brass cap stamped
 Set wooden post beside iron pipe

S498
 T 35 N R 11 E
 ¼C S / 26
 S / 35
 CPI 1975

T 35 N R 11 E

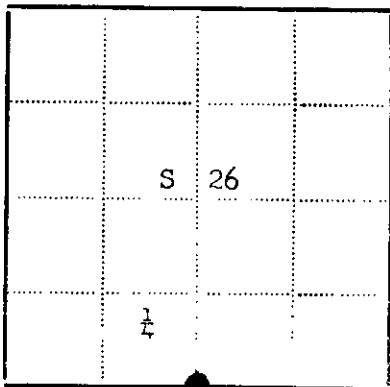

● - Corner monument restored
 □ -

Resident witnesses Glen Barker and Jim Claflin

Dated at Rhinelander Wisconsin, this 16th day of Sept 1975.

Signature *Philip T. Hansen* Title Registered Land Surveyor
 (County Surveyor, Registered Land Surveyor, or other duly authorized official)

Surveyors Registration No. S 498

Office of Register of Deeds County of Oneida

I hereby certify that the within instrument was filed in this office for record on the 14th day of October 1975, and was filed in Book No. Page No. of County Records.

Signature *Doris Verage Kuehn* Title Register of Deeds

Township 35 North Range 11 East Section 26 Index No. Page No.

3511260020

V-19