

CERTIFIED LAND CORNER RESTORATION

Index No. 1-16

State of Wisconsin } ss.


County of Oneida }

History of original corner establishment:  
No records of any previous survey.

I Philip T. Hansen, do hereby  
certify that on the 22nd day  
of February, 19 79, I found  
established ~~and located~~ the E 1/16  
corner of Sections 27 and 34

Township 35, North, Range  
11 East, Fourth Principal Meridian,  
as described hereon; and that from this evidence  
I established a new monument and accessories  
as described hereon to perpetuate the original  
location of this corner.

Resident witnesses:  
Glen Barker  
Jim Clafflin  
Herb Wagoner

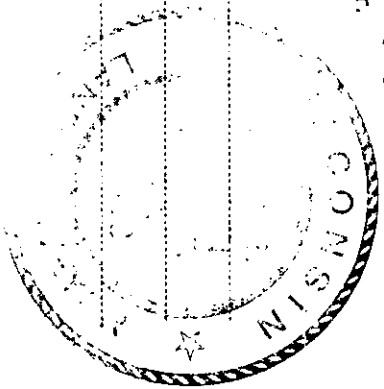

T35N	R11E
S 27	
134C.007	E 1/16 134C.007

○ = Corner monument restored.

Description of corner evidence found:  
No evidence of any corner recovered.  
Corner established by traverse and computation. Ran traverse from section corners 26, 27, 34 and 35 east to 1/4 corner between sections 27 and 34. Computed distance 2680.014 ft. at bearing N 89° 25' 55" W.  
Established E 1/16 at 134C.007 feet intermediate.

Description of monument and accessories I established to perpetuate the original location of this corner.  
Set a 1 1/2" iron pipe 8 feet long with 2" diameter brass cap, stamped:  
Monument projects 3' above the ice.  
Corner sets 8' east of the east shore of large island in the Wolf River.  
Marked NBR's - S498  
White Fine 7" S62°W 38.82 feet, scribed 1/16 BT T35N R11E  
White Fine 6" N45°W 19.20 feet, scribed 1/16 BT S 27  
E 1/16 S+34  
CPI-1979

Dated at Oneida, Wis., this 28th day of February, 1979

Signature Philip T. Hansen Title Registered Land Surveyor Registration No. S-498  
(County Surveyor, Registered Land Surveyor, or other duly authorized official)  
Office of Register of Deeds, County of Oneida  
Instrument was filed in this office for record on the 13th day of March, 1979  
at 1:30 o'clock P. M.

Terese Weidner Kuehn  
(Register of Deeds)

By \_\_\_\_\_ Deputy

3511270010