

CERTIFIED LAND CORNER RESTORATION



Index No. V-15

State of Wisconsin

County of Oneida } ss.

I, Phillip T. Hansen, do hereby certify that on the 21st day of February, 1979, I ~~established~~ ~~relocated~~ the Quarter corner of Sections 27 and 34, Township 35, North, Range 11, East, Fourth Principal Meridian, as described hereon; and that from this evidence I established a new monument and accessories as described hereon to perpetuate the original location of this corner.

Resident witnesses:
Glen Barker
Jim Claffin
Herb Wagoner

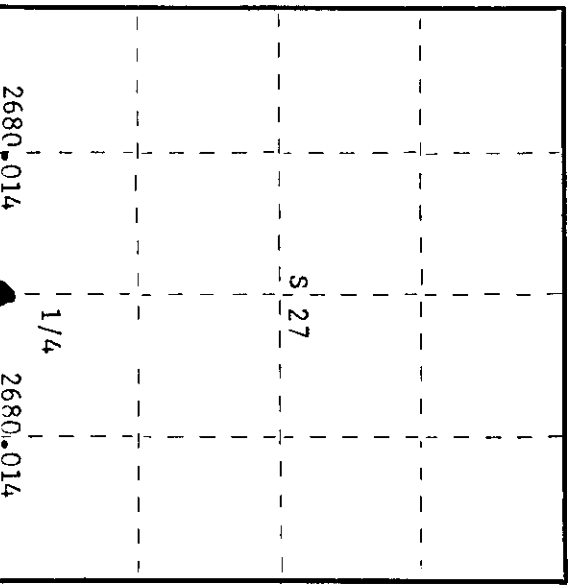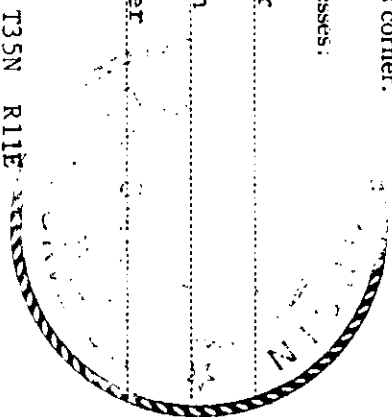

O = Corner monument restored.

History of original corner establishment:
 Original corner established by Wm. E. Dougherty, Deputy Surveyor, in 1859 from which Spruce 8" bears S32°E 26' and Spruce 8" bears N55°W 20 links. H.C. Lawrence's notes that he ran the N-S 1/4 line of section 35 to intersect his projected line between sections 26 and 35 but no corner was established. No evidence of any corner recovered.

Description of corner evidence found:
 No evidence of any corner recovered. Established the corner by running traverse between section corners 26, 27, 34 and 35 west to corners 27, 28, 33 and 34. Computed distance 5360.028 feet at bearing N 87° 55' 55" W.
 Set new 1/4 corner at 2680.014' intermediate.

Description of monument and accessories I established to perpetuate the original location of this corner.
 Unable to set a county monument because of water, bog and unstable conditions.
 Set a 1 1/2" x 13" iron pipe with 2" brass cap, stamped:
 Monument projects 30" above ice.
 Corner sets in flowage of Wolf River.
 Marked NBT's - White Pine 30" N72° 27' 08" E 523.68 feet
 Tamarack 6" S 8° 16' 41" E 499.62 feet
 Tamarack 6" S 2° 58' 10" W 404.92 feet
 Tamarack 4" S 17° 18' 59" W 352.66 feet
 all scribed 1/4 BT
 S498
 T35N R11E
 S 27
 1/4 S 34
 CPI-1979

Dated at Rhineland, Wis., this 28th day of February, 1979
 Signature: Phillip T. Hansen Title: Registered Land Surveyor Registration No. S-498
 (County Surveyor, Registered Land Surveyor, or other duly authorized official)

Office of Register of Deeds, County of Oneida
 Instrument was filed in this office for record on the 13th day of March, 1979
 at 1:30 o'clock P. M.

Donna L. Hager
 (Register of Deeds)

By: _____ Deputy

3511270020