

CERTIFIED LAND CORNER RESTORATION

Index No. **7-17**

State of Wisconsin }
County of Oneida } ss.

I Phillip T. Hansen, do hereby certify that on the 19th day of January, 1977, I found

evidence of the Quarter corner of Section 26 & 27 Township 35 North, Range 11 East, Fourth Principal Meridian,


as described hereon; and that from this evidence I established a new monument and accessories as described hereon to perpetuate the original location of this corner.

Resident witnesses:


Glen Barker

Jim Clarlin

Herb Wagoner

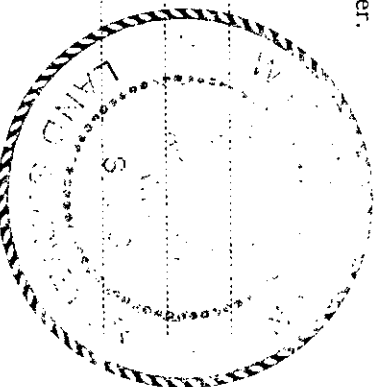

T35N R11E

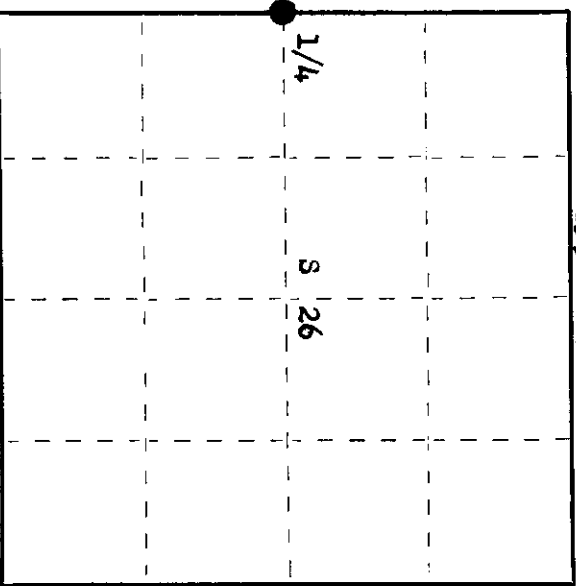

○ = Corner monument restored.

History of original corner establishment: Original Corner established by Wm. E. Dougherty, Deputy Surveyor, in 1859, from which Hemlock 11" bears S 76° W 14 links and Hemlock 10" bears N 81° E 13 links.
Corner recovered by D.H. Vaughan, County Surveyor, in 1914. Set new post and marked NBTs - White Pine 18" N 19 1/2° W 36 links and White Pine 18" S 71 1/2° E 28-3/4 links.

Corner recovered by H.C. Lawrence, Registered Land Surveyor, in 1959. Recovered stumps of Vaughan's BTs. Set new post and marked NBTs - Aspen 9" S 75° E 33 1/2 links and Aspen 8" N 40° W 31 1/2 links.

Description of corner evidence found:

Recovered Lawrence's 4" cedar post, squared and scribed 1/4 S S26, 1/4 S 27. Post was in very poor condition.

Recovered BT - Vaughan's White Pine stump, 18" N 19 1/2° W 36 links, axe marks visible.

White Pine stump 18" S 71 1/2° E 28.75 links, BT scribe marks visible.
Lawrence's Aspen 9" (12") S 75° E 33.5 links, scribed S26 NBT.
Aspen 8" (18") N 40° W 31.5 links, scribed S27.

Description of monument and accessories I established to perpetuate the original location of this corner.

Replaced Lawrence's 4" post with 2 1/2" Bernitsen A-1 Federal Monument, aluminum with magnet installed in cap and base. Cap stamped:

T35N R11E

Monument projects 24" above ground.
NBT - Maple 7" N 18° E 39.1 links, scribed 1/4 BT.
Maple 6" S 62° W 41 links, scribed 1/4 BT.

1/4 27 26
S498-1977

Dated at Rhineland, Wis., this 24th day of January, 1977

Signature Phillip T. Hansen Title Registered Land Surveyor Registration No. S-498
(County Surveyor, Registered Land Surveyor, or other duly authorized official)

Office of Registrar of Deeds, County of Oneida
Instrument was filed in this office for record on the 24th day of January, 1977
at 1:00 o'clock P. M.

Donna Terese Kuehn
(Registrar of Deeds)

By: _____ Deputy

000127200