

CERTIFIED LAND CORNER RESTORATION

Index No. 7-16


State of Wisconsin

County of Oneida } ss.

History of original corner establishment:

I Phillip T. Hansen, do hereby certify that on the 6th day of February, 1979, I ~~restored~~ established the EC 1/16 corner of ~~Section 27~~ Section 27 Township 35, North, Range 11 East, Fourth Principal Meridian, as described hereon; and that from this evidence I established a new monument and accessories as described hereon to perpetuate the original location of this corner.

Resident witnesses:
Glen Barker
Herb Wagoner
Jim Clafin

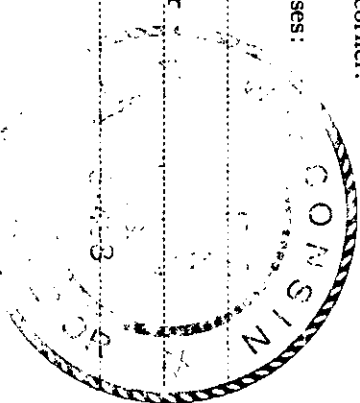

Description of corner evidence found:


No evidence of any corner recovered. Corner established by traverse and computation. Computed distance from E 1/4 corner section 27 to C 1/4 corner is 2751.685' at bearing N 87-48-46 W.
Set EC 1/16 at 1375.823' intermediate.

Description of monument and accessories I established to perpetuate the original location of this corner.

Set a 1 1/2" iron pipe with 2" brass cap projecting 18" above ground. Cap stamped:

Marked NBT's -
Maple 6" N22°W 43.28' scribed 1/16 BT. S498
Sugar 7" S40°W 33.80' scribed 1/16 BT. T35N R11E
EC 1/16 S427

CPI-1979

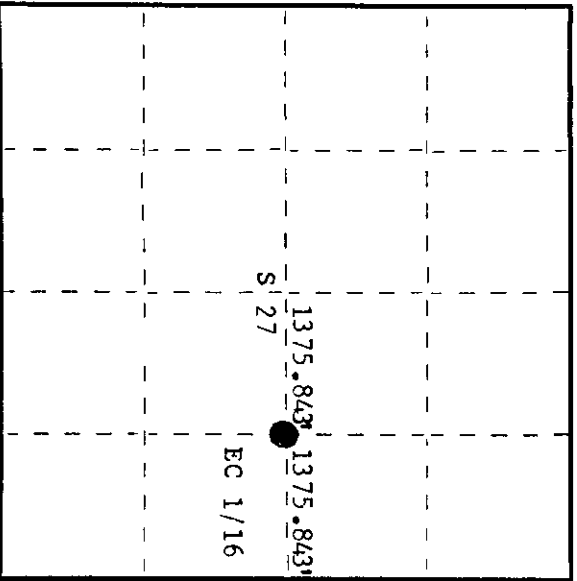

○ = Corner monument restored.

Dated at Rhinelander, Wis., this 22nd day of February, 1979

Signature Phillip T. Hansen Title Registered Land Surveyor Registration No. S-498
(County Surveyor, Registered Land Surveyor, or other duly authorized official)

Office of Register of Deeds, County of Oneida. I hereby certify that the within instrument was filed in this office for record on the 13th day of March, 1979 at 1:30 o'clock P. M.

Debra Leverage Fuchs
(Register of Deeds)

By: _____ Deputy

0102272010