

CERTIFIED LAND CORNER RESTORATION

Index No. 7-15

State of Wisconsin

County of Oneida } ss.

I, Phillip J. Hansen, do hereby certify that on the 13th day of February, 1979, I ~~found~~ restored the C 1/4 corner of Section 27



Township 35, North, Range 11 East, Fourth Principal Meridian, as described hereon; and that from this evidence I established a new monument and accessories as described hereon to perpetuate the original location of this corner.

Resident witnesses:

Glen Barker

Jim Clafflin

Herb Wagoner

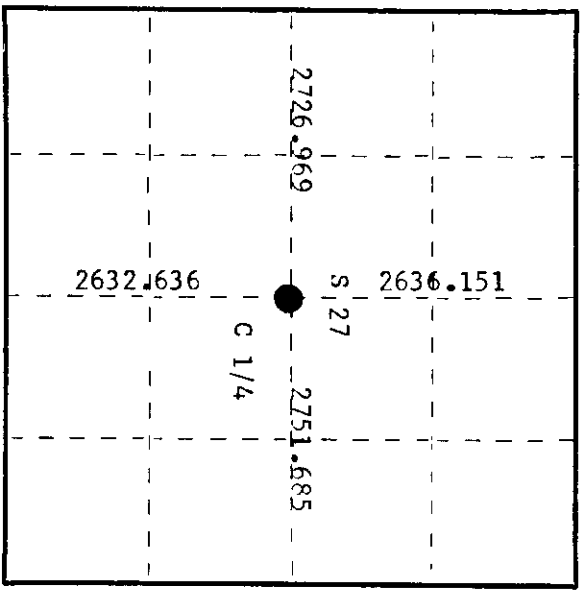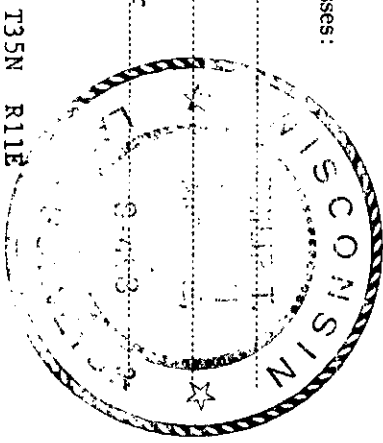

○ = Corner monument restored.

History of original corner establishment:

Description of corner evidence found:
No evidence of any corner found. Corner established by traverse and computation. Ran traverse from N 1/4 corner to S 1/4 corner and E 1/4 corner to W 1/4 corner. Established C 1/4 corner at S 0-04-01 W 2636.151' of N 1/4 corner - N 87-48-46 W 2751.685' of E 1/4 corner - N 0-04-01 E 2632.636' of S 1/4 corner and S 87-48-46 E 2726.969' of W 1/4 corner.

Description of monument and accessories I established to perpetuate the original location of this corner.
Set a 1 1/2" x 13" iron pipe with brass cap projecting 3" above ice. Cap stamped:
Marked NBT's - S498
Maple 8" S56°E 180.80' - scribed C 1/4 BT. T35N R11E
Red Pine 16" N23°W 259.42' - scribed C 1/4 BT.
Corner sets in flowage of Wolf River. C 1/4 S 27
CPI-1979

Dated at Rhineland, Wis., this 20th day of February, 1979

Signature Phillip J. Hansen Title Registered Land Surveyor Registration No. S-498
(County Surveyor, Registered Land Surveyor, or other duly authorized official)

Office of Register of Deeds, County of Oneida
Instrument was filed in this office for record on the 13th day of March, 1979
at 1:30 o'clock P. M.

Louise Savage Fuchs
(Register of Deeds)

By: _____ Deputy

351127 2020