

CERTIFIED LAND CORNER RESTORATION

Index No. S-15

History of original corner establishment:


State of Wisconsin } ss. County of Oneida

I Phillip T. Hansen, do hereby certify that on the 8th day of February, 1979, I found established of the NC 1/16 corner of Section 27 Township 35 North, Range 11 East, Fourth Principal Meridian, as described hereon; and that from this evidence I established a new monument and accessories as described hereon to perpetuate the original location of this corner.

Resident witnesses:

Glen Barker


Herb Wagoner

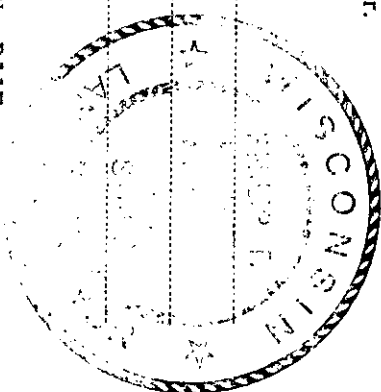

Description of monument and accessories I established to perpetuate the original location of this corner. Set a 1 1/2" iron pipe with 2" brass cap projecting 18" above ground. Cap stamped:

Marked NBT's - S498 T35N R11E
Maple 6" N68°E 14.65' - scribed 1/16 BT.
Maple 6" S41°W 15.13' - scribed 1/16 BT.
NC 1/16 S+27

CPI-1979

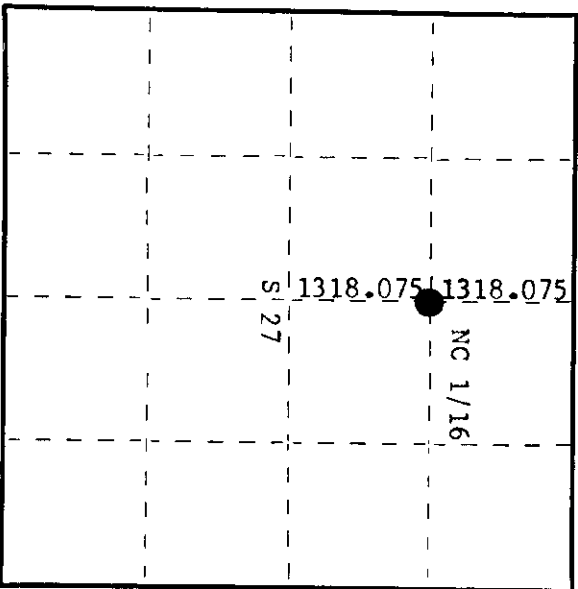

O = Corner monument restored.

Dated at Rhinelander, Wis., this 20th day of February, 1979.

Signature: Phillip T. Hansen, Registered Land Surveyor, or other duly authorized official. Title: Registered Land Surveyor. Registration No. S-498.

Office of Register of Deeds, County of Oneida. Instrument was filed in this office for record on the 13th day of March, 1979, at 3:00 o'clock P.M. I hereby certify that the within

at 3:00 o'clock P.M. (Register of Deeds) [Signature]

By: [Signature] Deputy

3511273020