CERTIFIED LAND CORNER RESTORATION

Index No. V-6

State of Wisconsin
County of Oneida } ss.

I Philip T. Hansen, do hereby certify that on the 1st day of August, 19 78, I ~~found~~ established ~~and~~ the W. 1/16 corner of Section 29 & 32 Township 35, North, Range 11 East, Fourth Principal Meridian, as described hereon; and that from this evidence I established a new monument and accessories as described hereon to perpetuate the original location of this corner.

Resident witnesses:

Jim Claflin

Herb Wagoner

John Masbaum

WISCONSIN
PHILIP T. HANSEN
ARGONNE, WIS.
S-498
LAND SURVEYOR

T35N R11E

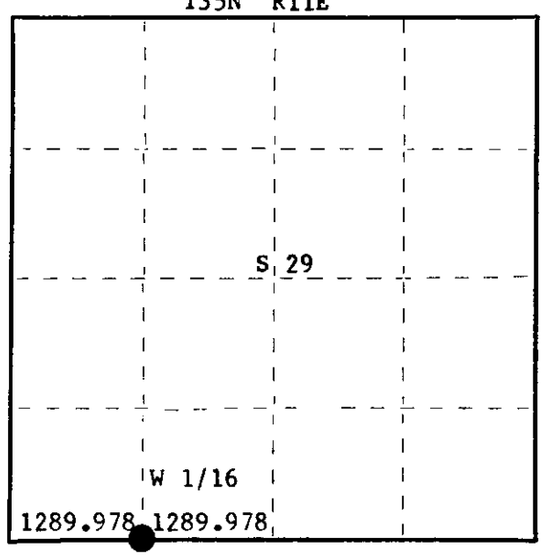

○ = Corner monument restored.

History of original corner establishment:

No records of any previous survey.

Description of corner evidence found:

No evidence of any corner recovered. Corner established by traverse and computation. Ran traverse from previously established 1/4 corner between section 29 & 32 to section corner 29, 30, 31 & 32. Computed distance 2579.956 feet at bearing N 88° 38' 57" W. Established W 1/16 at 1289.978 feet intermediate.

Description of monument and accessories I established to perpetuate the original location of this corner.

Set 1½" iron pipe with 2" brass cap projecting 24" above ground, cap stamped:

Marked NBT's - W.Spruce 10" N46°W, 11.4'
Cedar 10" S65°W, 9.6 feet,
both scribed 1/16 BT.

S498
T35N R11E
W 1/16 S 29 + S 32
CPI-1978

Dated at Rhinelander, Wis., this 7th day of August, 19 78.

Signature Philip T. Hansen Title Registered Land Surveyor Registration No. S-498
(County Surveyor, Registered Land Surveyor, or other duly authorized official)

Office of Register of Deeds, County of Oneida, I hereby certify that the within instrument was filed in this office for record on the 18th day of September, 19 78 at 1:00 o'clock P. M.

Doris Verage Kuehn
(Register of Deeds)

By ..... Deputy

FORM 985 H C MILLER CO., MILWAUKEE

35/129 0030