

CERTIFIED LAND CORNER RESTORATION



Index No. U-8

State of Wisconsin } ss.
County of Oneida

I Phillip T. Hansen, do hereby certify that on the 27th day of July, 1978, I ~~found~~ established the SE 1/16 corner of Section 29 Township 35, North, Range 11 East, Fourth Principal Meridian,

as described hereon; and that from this evidence I established a new monument and accessories as described hereon to perpetuate the original location of this corner.

Resident witnesses:
Glen Barker
Jim Claflin
Herb Wagoner

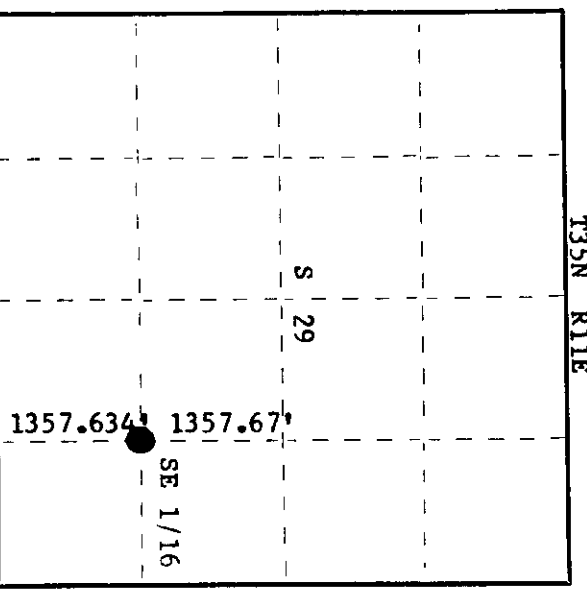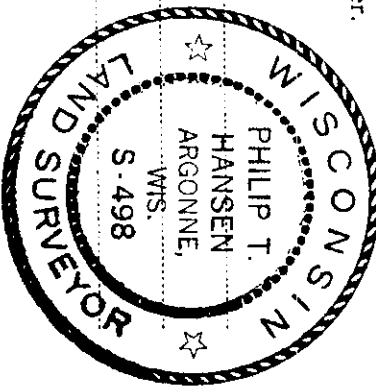

○ = Corner monument restored.

History of original corner establishment:
No records available on any previous survey.

Description of corner evidence found:

No evidence of any corner recovered.
Corner established by traverse and computation. Computed the line between the E 1/16 corner and the EC 1/16. Computed distance 2715.304 feet at bearing N 2° 22' 20" E. Computed location of SE 1/16 corner is 1357.634' N 2° 22' 20" E of E 1/16 corner and 1357.61 S 2° 22' 20" W of EC 1/16 corner.

Description of monument and accessories I established to perpetuate the original location of this corner.

Set 1 1/2" iron pipe with 2" brass cap projecting 24" above ground, cap stamped:
Marked NBT's - sugar 8" S80°W 19.55 feet S498
sugar 7" N42°E 30.55 feet T35N R11E
both scribed 1/16 BT SE 1/16 S 29
CPI-1978

Dated at Rhineland, Wis., this 7th day of August, 1978.

Signature Phillip T. Hansen Title Registered Land Surveyor Registration No. S-498
(County Surveyor, Registered Land Surveyor, or other duly authorized official)

Office of Register of Deeds, County of Oneida
Instrument was filed in this office for record on the 21st day of August, 1978
at 100 o'clock M. I hereby certify that the within

Donie Verage Fuchs
(Register of Deeds)

By _____ Deputy

3511291010