

CERTIFIED LAND CORNER RESTORATION

Index No. 7-7


State of Wisconsin

County of Oneida } ss.

History of original corner establishment:
No records of any previous survey.

I Phillip T. Hansen, do hereby certify that on the 15th day of August, 1978, I found ~~restored~~ found the C 1/4 corner of Section 29 Township 35, North, Range 11 East, Fourth Principal Meridian, as described hereon; and that from this evidence I established a new monument and accessories as described hereon to perpetuate the original location of this corner.

Resident witnesses:
Glen Barker
Jim Claflin
Herb Wagoner
John Masbaum

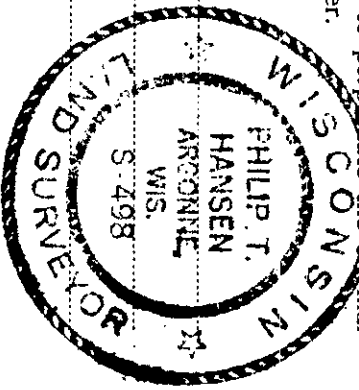


Description of corner evidence found:

No evidence of any corner recovered. Corner established by traverse and computation. Ran traverse from previously recovered N 1/4 corner to the S 1/4 corner and from W 1/4 corner to E 1/4 corner to establish C 1/4 corner. Corner sets S 1° 44' 30" W, 2687.797 ft. from N 1/4 corner, N 1° 44' 30" 2687.864' from South 1/4 corner, N 89° 49' 26" W, 2641.185' of E 1/4 corner and S 89° 49' 26" E 2640.394 ft. from W 1/4 corner.

Description of monument and accessories I established to perpetuate the original location of this corner.
Set 2-1/2" Bernitsen A-1 Federal Monument (CPI) projecting 24" - cap stamped:
Placed a rock cairn around base of monument.
Corner sets in a tag alder swamp. No B.T.'s available.

- Set 3 - 1-1/2" iron pipes for witness monuments.
- #1 - North 30.0 feet T35N R11E
- #2 - East 18.0 feet C 1/4 S 29
- #3 - West 15.0 feet S498 - 1978

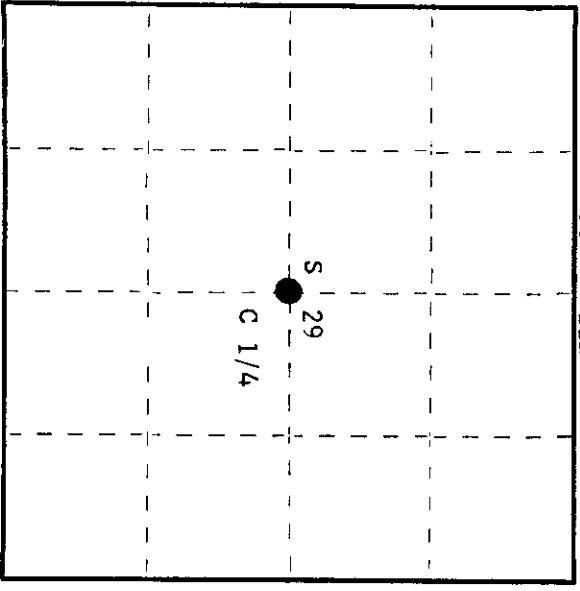

○ = Corner monument restored.

Dated at Rhinelander, Wis., this 21st day of August, 1978.

Signature Phillip T. Hansen Title Registered Land Surveyor Registration No. S-498
(County Surveyor, Registered Land Surveyor, or other duly authorized official)

Office of Register of Deeds, County of Oneida. I hereby certify that the within instrument was filed in this office for record on the 21st day of May, 1979 at 9:00 o'clock P. M.

Signature Donna Savage Kuchai
(Register of Deeds)

By Donna Savage Kuchai Deputy

351129 2020