
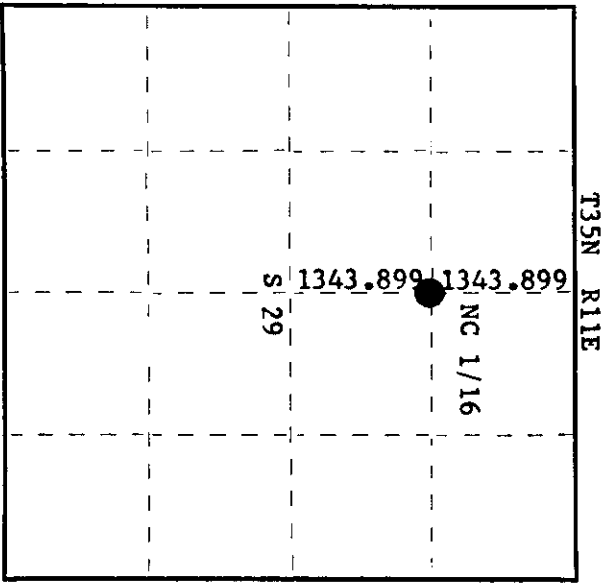


State of Wisconsin }  
County of Oneida } ss.

I Phillip T. Hansen, do hereby certify that on the 11th day of August, 1978, I ~~found~~ ~~restored~~ the NC 1/16 corner of Section 29 Township 35, North, Range 11 East, Fourth Principal Meridian, as described hereon; and that from this evidence I established a new monument and accessories as described hereon to perpetuate the original location of this corner.

Resident witnesses:  
Glen Barker  
Jim Clafflin  
Herb Wagoner  
John Masbaum

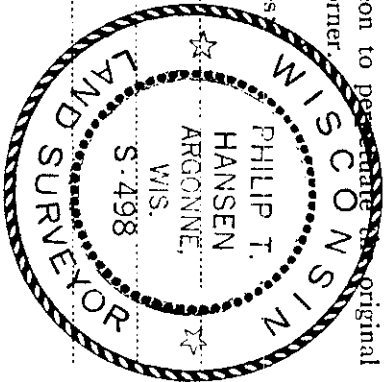

○ = Corner monument restored.

History of original corner establishment:

No records of any previous surveys.

Description of corner evidence found:

No evidence of any corner recovered. Corner established by traverse and computation. Computed distance from N 1/4 corner to established C 1/4 corner is 2687.797 feet at bearing S 1° 44' 30" W.  
Set NC 1/16 corner at 1343.899 feet intermediate.

Description of monument and accessories I established to perpetuate the original location of this corner.

Set 1 1/2" iron pipe with 2" brass cap projecting 18" above ground. Cap stamped:  
Built a large rock calrn around base of monument.  
Marked NBT's -  
Maple 6" N7°W 10.14', scribed 1/16 BT. S498  
Maple 5" N58°E 11.25', scribed 1/16 BT. T35N R11E  
NC 1/16 S 29  
CPI-1978

Dated at Rhineland, Wis., this 14th day of August, 1978

Signature Phillip T. Hansen Title Registered Land Surveyor Registration No. S-498  
(County Surveyor, Registered Land Surveyor, or other duly authorized official)

Office of Register of Deeds, County of Oneida  
Instrument was filed in this office for record on the 18th day of September, 1978  
at 10 o'clock P. M.

Doris Venage Fuesler  
(Register of Deeds)

By: \_\_\_\_\_ Deputy