
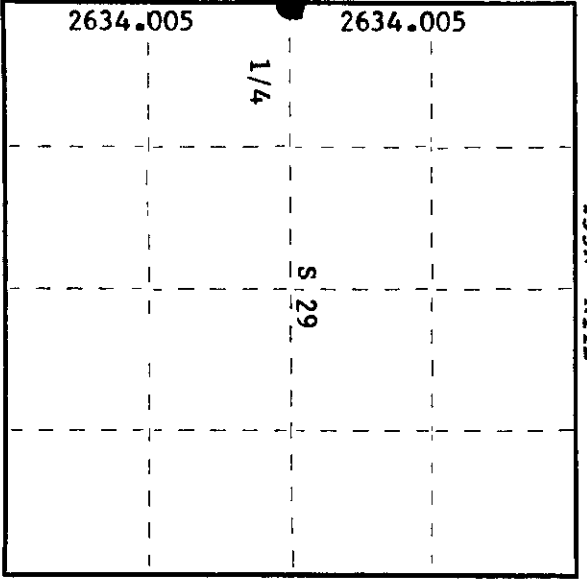


State of Wisconsin }  
County of Oneida } ss.

I, Phillip T. Hansen, do hereby certify that on the 17th day of July, 1978, I ~~restored~~ **established** ~~re-established~~ the Quarter corner of Section 29 & 30 Township 35 North, Range 11 East, Fourth Principal Meridian, as described hereon; and that from this evidence I established a new monument and accessories as described hereon to perpetuate the original location of this corner.

Resident witnesses:  
Glen Barker  
Jim Clafflin  
Herb Wagoner

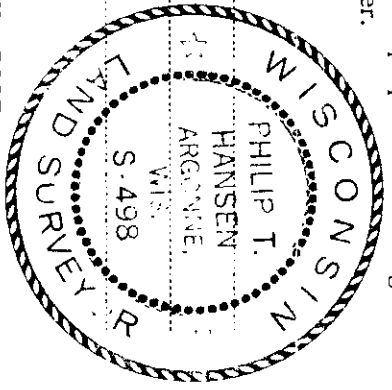

○ = Corner monument restored.

History of original corner establishment:

Original corner established by Wm. E. Dougherty, Deputy Surveyor, in 1859, from which hemlock 6" bears N 41° W, 8 links and hemlock 8" bears S 14° E, 6 links. No record of any subsequent survey.

Description of corner evidence found:

No evidence of any corner recovered. Corner set by proportion from traverse and computation. Ran traverse from re-established section corner 19, 20, 30, 29 to section corner 30, 29, 31 and 32. Computed distance 5268.01 feet at bearing S 0° 26' 49" W. Set 1/4 corner at 2634.005' intermediate.

Description of monument and accessories I established to perpetuate the original location of this corner.

Set a 2 1/2" Bernitsen A-1 Federal Monument (Oneida County), projecting 24" above ground

Cap stamped:

- Marked NBT's -
- White Birch 8" N56°W, 77.70 feet T35N R11E
  - Maple 6" S88°W, 46.45 feet 1/4 30 + 29
  - Maple 6" S22°W, 16.80 feet
  - Maple 6" S28°W, 86.85 feet S498 - 1978
  - all BT's scribed 1/4 BT.

Dated at Rhineland, Wis., this 26th day of July, 1978.

Signature Phillip T. Hansen Title Registered Land Surveyor Registration No. S-498  
(County Surveyor, Registered Land Surveyor, or other duly authorized official)

Office of Register of Deeds, County of Oneida, I hereby certify that the within instrument was filed in this office for record on the 14th day of August, 1978 at 12:45 o'clock P. M.

Doris George Fuchs  
(Register of Deeds)

By: \_\_\_\_\_ Deputy

3511302000