
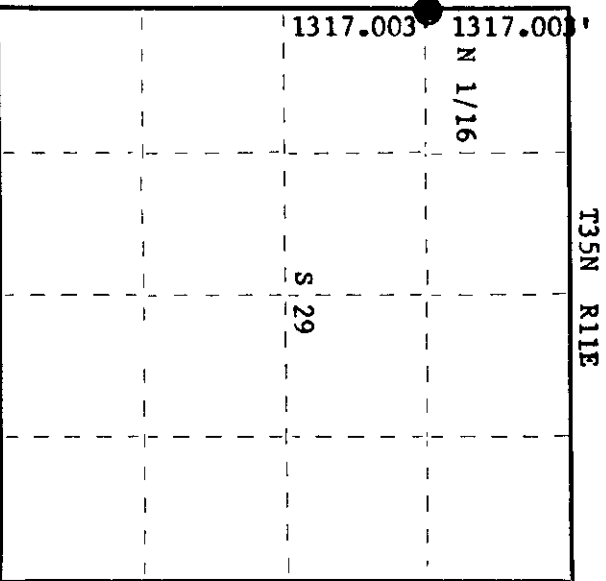


State of Wisconsin }
County of Oneida } ss.

I, Phillip T. Hansen, do hereby certify that on the 17th day of July, 1978, I ~~found~~ **established** ~~the~~ **the** N 1/16 corner of Section 29-30 Township 35 North, Range 11 East Fourth Principal Meridian, as described hereon; and that from this evidence I established a new monument and accessories as described hereon to perpetuate the original location of this corner.

Resident witnesses:
Glen Barker
Jim Clafin
Herb Wagoner
John Masbaum

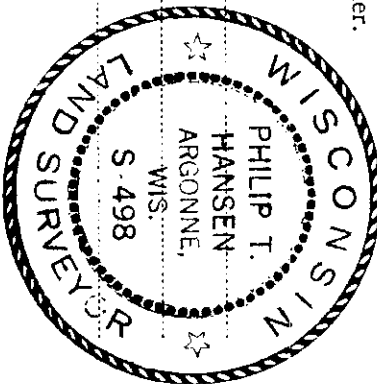

○ = Corner monument restored.

History of original corner establishment:
No records of any previous surveys

Description of corner evidence found:

No evidence of any corner recovered.
Corner established by proportion. Ran traverse from section corner 19, 20, 29 & 30 to section corner 29, 30, 31 & 32, to establish the 1/4 corner. Computed distance from section corner 19, 20, 29 & 30 to section corner 29, 30, 31, 32 is 5268.01. Set N 1/16 corner at 1317.003 feet at bearing S 0° 26' 49" W.

Description of monument and accessories I established to perpetuate the original location of this corner.

Set a 1 1/2" iron pipe with 2" brass cap, projecting 24" above ground, stamped:
Marked NBT's -
Maple 7" N11°W 24.42 feet
Maple 7" S57°W 26.12 feet, scribed 1/16 BT

S498
T35N R11E
N 1/16 30+29
CPI-1978

Dated at Rhineland, Wis., this 26th day of July, 1978.

Signature Phillip T. Hansen Title Registered Land Surveyor Registration No. S-498
(County Surveyor, Registered Land Surveyor, or other duly authorized official)

Office of Register of Deeds, County of Oneida
Instrument was filed in this office for record on the 14th day of August, 1978
at 12:45 o'clock P. M.

Doris Verage Fisher
(Register Deeds)

By: _____ Deputy

351303000