

CERTIFIED LAND CORNER RESTORATION

Index No. 2-5

State of Wisconsin

County of Oneida

ss.



I, Philip T. Hansen, do hereby certify that on the 23rd day of October, 1978, I found evidence of the Section corner of Section 31, 32, 6 & 5 Township 35 - 34, North, Range 11 East, Fourth Principal Meridian, as described hereon; and that from this evidence I established a new monument and accessories as described hereon to perpetuate the original location of this corner.

Resident witnesses:

Glen Barker

Jim Claffin

Herb Wagoner

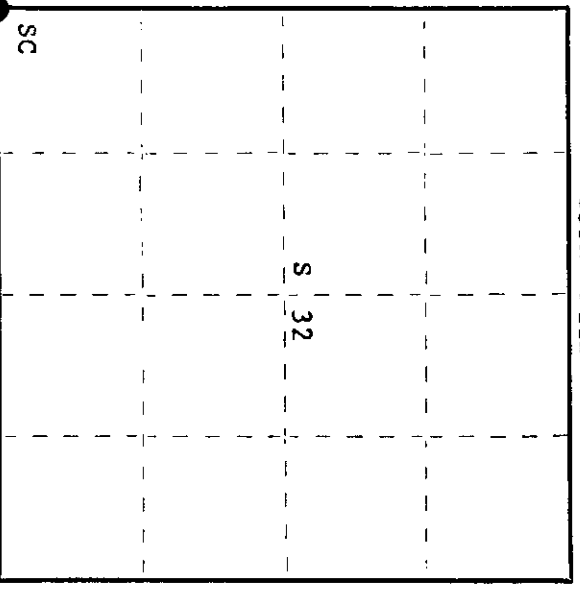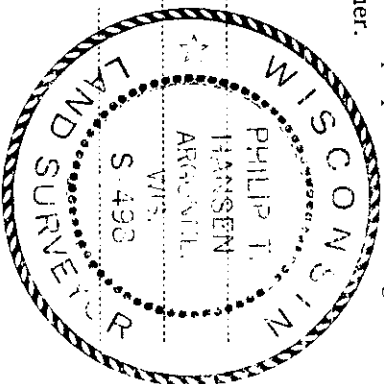

○ = Corner monument restored.

History of original corner establishment:

Original corner established by Hiram C. Fellows, Deputy Surveyor, in 1859 from which white birch 8" bears N 23° W 20 links; aspen 8" bears N 43° E 29 links; cedar 12" bears S 81° E 25 links; white birch 8" bears S 69° W 25 links. No records of any subsequent survey.

Description of corner evidence found:

Recovered a very old 1-3/4" iron pipe projecting 24" above ground (origin unknown). This corner has been recognized and used by local land owners for many years. Searched for BT's but found nothing. Used this corner for control for traverse and computation of south line.

Description of monument and accessories I established to perpetuate the original location of this corner.

Replaced old iron pipe with 2 1/2" iron pipe with brass cap.  
 Monument projects 18" above ground. Cap stamped:  
 Corner sets 2.80 chains south of Pedro Creek.  
 Marked NBT's - Sugar 6" N70°E 30.7 feet T35N R11E  
 Sugar 5" N52°E 15.62 feet 31 32  
 W. Birch 5" N69°W 24.09 feet 6 15  
 W. Birch 8" S14°W 32.71 feet T34N R11E  
 all scribed SC BT S498 - 1978

Dated at Rhineland, Wis., this 30th day of October, 1978

Signature Philip T. Hansen Title Registered Land Surveyor Registration No. S-498  
 (County Surveyor, Registered Land Surveyor, or other duly authorized official)

Office of Register of Deeds, County of Oneida  
 Instrument was filed in this office for record on the 24th day of November, 1978  
 at 10:00 o'clock A. M.

Doree Leverage Fuchs  
 (Register of Deeds)

By: \_\_\_\_\_ Deputy

3511310000