

CERTIFIED LAND CORNER RESTORATION

Index No. **X-5**

State of Wisconsin

County of Oneida } ss.



I, Philipp T. Hansen, do hereby certify that on the 26th day of January, 19 78, I found evidence of the Quarter corner of Sec. 31 & 32 Township 35 North, Range 11 East, Fourth Principal Meridian, as described hereon; and that from this evidence I established a new monument and accessories as described hereon to perpetuate the original location of this corner.

Resident witnesses:

Glen Barker

Jim Claffin

Herb Wagoner

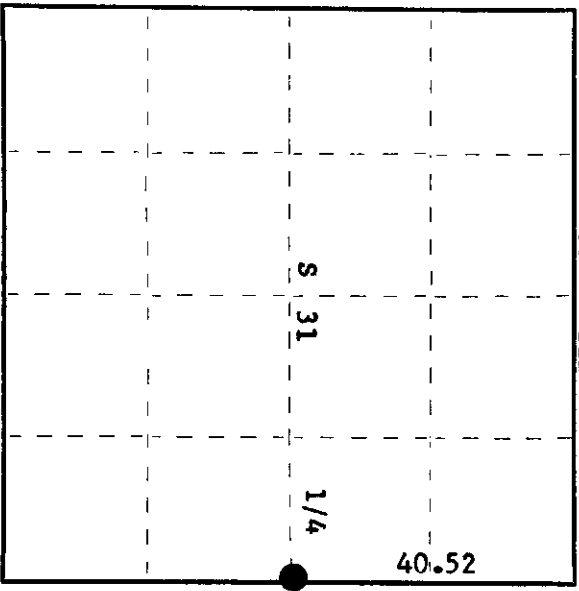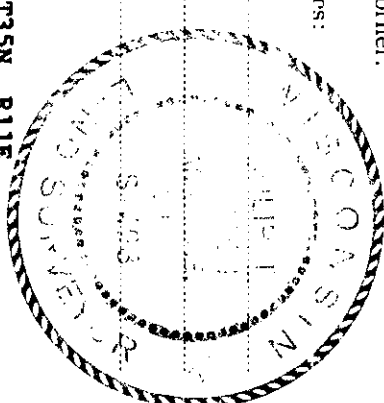

○ = Corner monument restored.

History of original corner establishment:

Original corner established by Wm. E. Dougherty, Deputy Surveyor, in 1859 from which Tamarack 10" bears S74°W, 11 links and Fir 8" bears S69°E, 8 links. Corner recovered by D.H. Vaughan, County Surveyor, in 1906. Recovered witness tree which checked out O.K. Corner re-established by Genisot (Gaartz). Set new post and marked NBT. Corner recovered by H.C. Lawrence, Registered Land Surveyor, in 1952. Recovered post and BT. Set new post, but no mention made of any BT's marked.

Description of corner evidence found:

Recovered Lawrence's 5" square cedar post, scribed 1/4S, S31, 1/4S S32 in very poor condition.  
Recovered aspen stump 9" S70°W, 18.5 links (Gaartz), scribed 1/4 S31 BT.

Description of monument and accessories I established to perpetuate the original location of this corner.

Replaced 5" cedar post with 2 1/2" Bernsten A-1 Federal Monument, stamped:  
Monument projects 12" above ground.  
Marked NBT's - Maple 7" N31°W, 18.5 links, scribed 1/4 BT. S498  
Cedar 8" S45°E, 61.8 links, scribed 1/4 BT. T35N  
Cedar 6" N78°E, 76 links, scribed 1/4 BT. 31+32  
Maple 5" S25°W, 47.9 links, scribed 1/4 BT.  
Corner sets 18 links west of an old N-S logging road, now grown up with brush. R11E 1978

Dated at Rhineclander, Wis., this 27th day of January, 19 78.

Signature Philipp T. Hansen Title Registered Land Surveyor Registration No. S-498  
(County Surveyor, Registered Land Surveyor, or other duly authorized official)

Office of Registrar of Deeds, County of Oneida. I hereby certify that the within instrument was filed in this office for record on the 26th day of January, 19 78 at 9:30 o'clock A. M.

Doris Venge Kuehn  
(Registrar of Deeds)

By: \_\_\_\_\_ Deputy

3511312000