

CERTIFIED LAND CORNER RESTORATION

Index No. X-4

State of Wisconsin


County of Oneida

History of original corner establishment:


ss.

I Phillip T. Hansen do hereby certify that on the 8th day of May, 1980, I ~~found~~ established the EC 1/16 corner of Section 31 Township 35 North, Range 11 East, Fourth Principal Meridian, as described hereon; and that from this evidence I established a new monument and accessories as described hereon to perpetuate the original location of this corner.

Resident witnesses:  
Glen Barker  
Jim Claffin  
Herb Wagoner

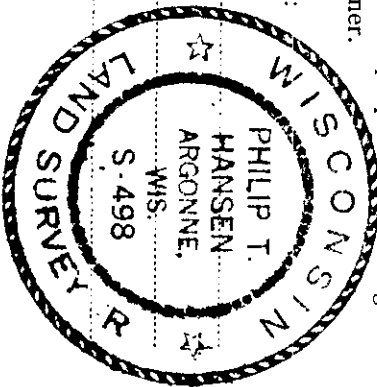

T35N R11E

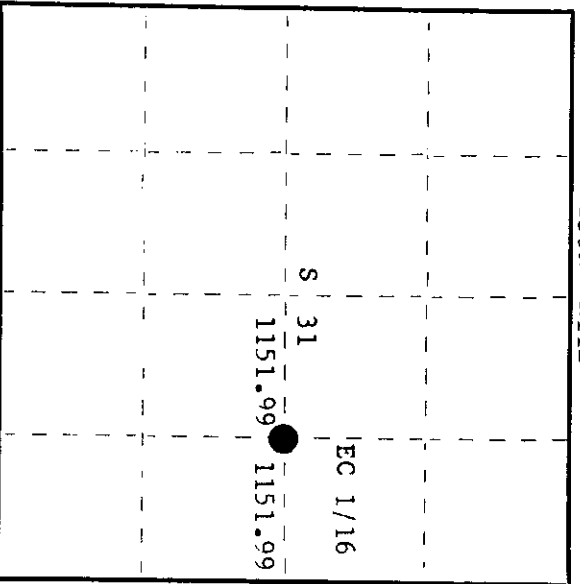

O = Corner monument restored.

Description of corner evidence found:

No evidence of any corner recovered.  
Corner established by traverse and computation. Ran traverse from E 1/4 Section 31 to previously established C 1/4. Computed distance is 2303.97 feet at bearing S 39° 31' 22 W. Set EC 1/16 at 1151.99 feet intermediate.

Description of monument and accessories I established to perpetuate the original location of this corner.

Set a 1-1/2" iron pipe with 2" brass cap projecting 24" - stamped:  
Marked NBT's -  
Maple 5" S46°E 23.83'  
Maple 6" S68°W 6.22'  
both scribed 1/16 BT.

S498  
T35N R11E  
EC 1/16 S-31  
CPI-1980

Dated at Rhinelanders, Wis., this 30th day of May, 1980

Signature: Phillip T. Hansen, Title: Registered Land Surveyor, Registration No. S-498  
County Surveyor, Registered Land Surveyor, or other duly authorized official)

Office of Register of Deeds, County of Oneida  
at 1:30 o'clock M. I hereby certify that the within instrument was filed in this office for record on the 5th day of June, 1980

Signature: Dennis Verage Kuehn  
(Register of Deeds)

By: Deputy

3511312010