

CERTIFIED LAND CORNER RESTORATION


Index No. X-3

State of Wisconsin

County of Oneida } ss.

I, Phillip T. Hansen, do hereby certify that on the 8th day of May, 1980, I reestablished the C 1/4 corner of Section 31 Township 35 North, Range 11 East, Fourth Principal Meridian, as described hereon; and that from this evidence I established a new monument and accessories as described hereon to perpetuate the original location of this corner.

Resident witnesses: Glen Barker, Jim Clafflin, Herb Wagoner

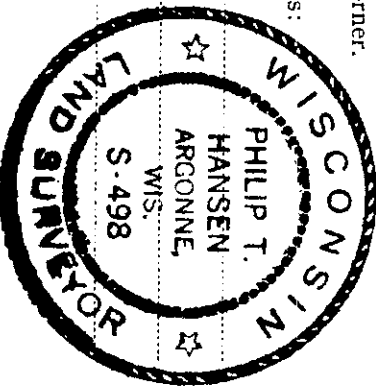


History of original corner establishment:

Description of corner evidence found:

No evidence of any corner recovered. Corner established by traverse and computation - ran traverse from W 1/4 to E 1/4. Computed position of C 1/4 corner is S 9° 0' 29" W 2677.00 from N 1/4; S89°31'22"W 2303.97' from E 1/4 N9°01'29"E, 2726.18' from S 1/4 and N89°31'22"E, 3011.844 of W 1/4.

Description of monument and accessories I established to perpetuate the original location of this corner. Set a 2-1/2" Berntsen A-1 Federal Monument for C 1/4, projecting 18" - cap stamped: Marked NBT's -

- B. Ash 6" N3°E 8.57' T35N R11E
B. Ash 8" due west 8.72'
Maple 10" S22°E 24.30'
B. Ash 4" N83°E 18.96' C 1/4 S 1/4
all scribed C 1/4 BT. S498 - 1980

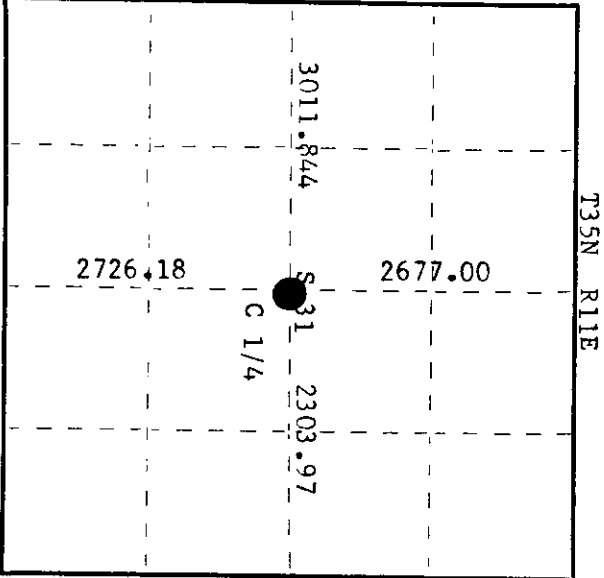

O = Corner monument restored.

Dated at Rhinelanders, Wis., this 30th day of May, 1980

Signature: Phillip T. Hansen, Registered Land Surveyor, Title: Registered Land Surveyor, Registration No. S-498

Office of Register of Deeds, County of Oneida, I hereby certify that the within instrument was filed in this office for record on the 31st day of July, 1980 at 3:35 o'clock P.M.

Signature: Doris Lange Fuchs, (Register of Deeds)

By: Deputy

3511312020