

CERTIFIED LAND CORNER RESTORATION



Index No. X-9

State of Wisconsin }
County of Oneida } ss.

I Phillip T. Hansen, do hereby certify that on the 4th day of December, 1978, I ~~was~~ established the Quarter corner of Sec. 32 & 33 Township 35 North, Range 11 East, Fourth Principal Meridian,

as described hereon; and that from this evidence I established a new monument and accessories as described hereon to perpetuate the original location of this corner.

Resident witnesses:
Glen Barker
Jim Claflin

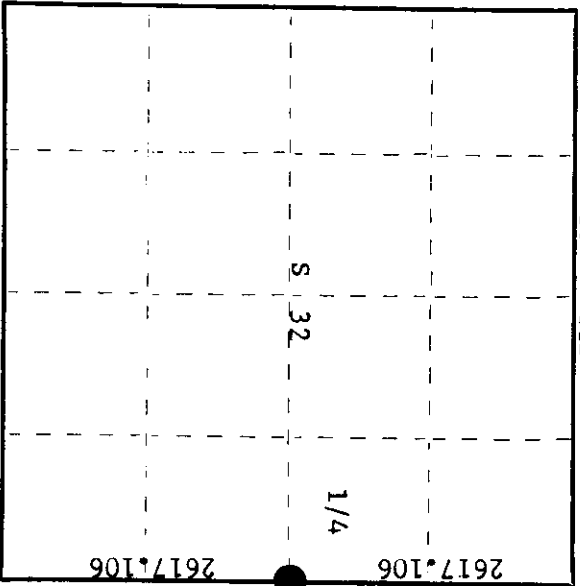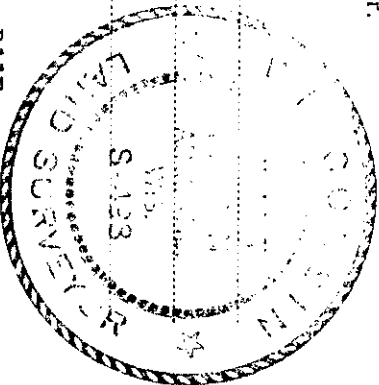

○ = Corner monument restored.

History of original corner establishment:

Original corner established by Wm. E. Dougherty, Deputy Surveyor, in 1859 from which tamarack 8" bears N40°W, 8 links and tamarack 10" bears S81°E, 11 links. H.C. Lawrence, Registered Land Surveyor, ran this line in 1952, but found no evidence of 1/4 corner or the SE section corner.

Description of corner evidence found:

No evidence of any corner recovered. Corner established by traverse and computation when subdividing the section. Ran traverse from section corner 28, 29, 32 & 33, 35-11 to section corner 4, 5, 32 & 33, 34, 35-11. Computed distance is 5234.212 feet at bearing S 1° 59' 34" W.
Set 1/4 corner at 2617.106 feet intermediate. Center falls on the south edge of a 12" cedar stump, fresh cut in survey line.

Description of monument and accessories I established to perpetuate the original location of this corner.
Set a 16 penny nail in stump for true corner.
Set a 2 1/2" Berntsen A-1 Federal Monument (O.C.) 3 feet south for witness corner.
Monument projects 6" above ground - cap stamped:

Marked NBT's -

Cedar 6" S26°W	24.58'	T35N R11E
Cedar 6" S32°E	8.72'	32 + 33
Cedar 7" N35°E	8.47'	1/4
Cedar 6" N54°W	21.22'	S498 - 1978

all scribed 1/4 BT 3 ft. N to Cor.

Dated at Rhineland, Wis., this 11th day of December, 1978

Signature Phillip T. Hansen Title Registered Land Surveyor Registration No. S-498
(County Surveyor, Registered Land Surveyor, or other duly authorized official)

Office of Register of Deeds, County of Oneida, I hereby certify that the within instrument was filed in this office for record on the 25th day of December, 1978 at 1:15 o'clock P.M.

Donna Weir
(Register of Deeds)

By _____ Deputy

351132 2000