CERTIFIED LAND CORNER RESTORATION

Index No. W-8

State of Wisconsin
County of Oneida } ss.

I Philip T. Hansen, do hereby certify that on the 15th day of November, 1978, I ~~found~~ established ~~xxxxxxxx~~ the NE 1/16 corner of Section 32 Township 35, North, Range 11 East, Fourth Principal Meridian, as described hereon; and that from this evidence I established a new monument and accessories as described hereon to perpetuate the original location of this corner.

Resident witnesses:

Glen Barker

Jim Claflin

Herb Wagoner

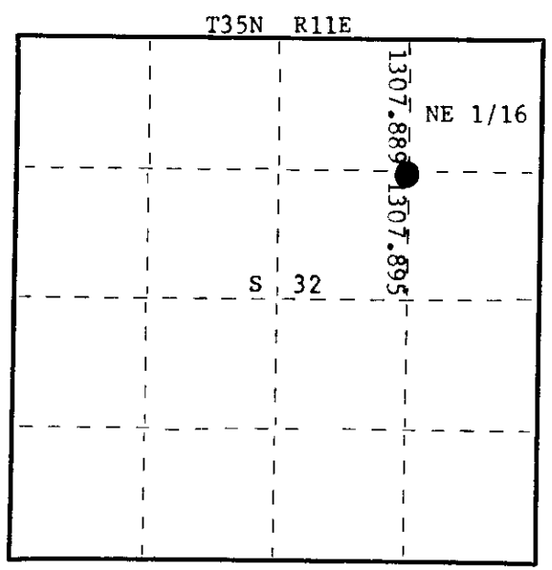

O = Corner monument restored.

History of original corner establishment:

No records of any previous survey

Description of corner evidence found:

No evidence of any corner recovered. Corner established by traverse and computation during resurvey of section 32. Computed line between E 1/16, section 29 and 32 and EC 1/16 of section 32 is 2615.784 feet at bearing S 3° 11' 33" W. Computed location of NE 1/16 corner is 1307.889' S 3° 11' 33" W of E 1/16 and N 3° 11' 33" E, 1307.895 feet from EC 1/16.
Corner falls in the north ditch line of Pratt Junction road.

Description of monument and accessories I established to perpetuate the original location of this corner.
Set 1½" x 5' iron pipe for true corner, projecting 12".
Set a 1½" iron pipe with 2" brass cap, 25' due south of true corner for witness corner, projecting 18" above ground, cap stamped:
Marked NBT's -
Jack Pine 5" N43°E, 22.12 feet, scribed 1/16 BT
B. Spruce 4" N14°W, 93.10 feet, scribed 1/16 BT

S498
T35N R11E
NE 1/16 S 32 W.C.
S-25 ft.
CPI-1978

Dated at Rhinelander, Wis., this 4th day of December, 1978

Signature Philip T. Hansen Title Registered Land Surveyor Registration No. S-498
(County Surveyor, Registered Land Surveyor, or other duly authorized official)

Office of Register of Deeds, County of Oneida, I hereby certify that the within instrument was filed in this office for record on the 10th day of January, 1979 at 1:00 o'clock P. M.

Doris Verage Kuehn
(Register of Deeds)

By ..... Deputy

FORM 985 H. C. MILLER CO., MILWAUKEE

35/132 3040