

CERTIFIED LAND CORNER RESTORATION

Index No. W-6

State of Wisconsin }
County of Oneida } ss.



History of original corner establishment:
No records of any previous survey.

I, Phillip T. Hansen, do hereby
certify that on the 15th day
of November, 1978, I ~~found~~
~~restored~~ the NW 1/16
corner of Section 32

Township 35, North, Range
11 East, Fourth Principal Meridian,
as described hereon; and that from this evidence
I established a new monument and accessories
as described hereon to perpetuate the original
location of this corner.

Resident witnesses:

- Glen Barker
- Jim Claflin
- Herb Wagoner

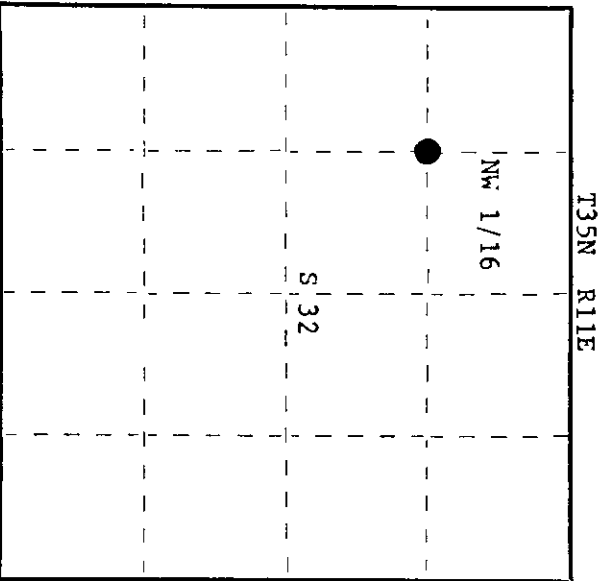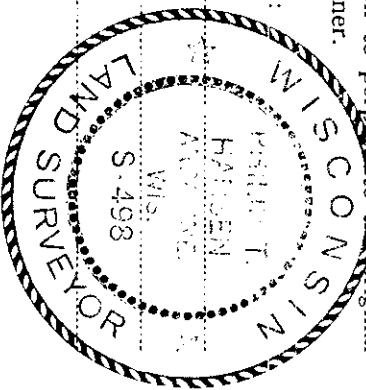

○ = Corner monument restored.

Description of corner evidence found:

No evidence of any corner recovered.

Corner established by traverse and computation during resurvey of section 32.
Computed distance between W 1/16, section 29 and 32 and WC 1/16 corner is 2620.354 feet
at bearing S 6° 36' 55" W. Established corner at 1310.191 feet S 60° 36' 55" W of
W 1/16 and 1310.173 feet N 6° 36' 55" E of WC 1/16.

Description of monument and accessories I established to perpetuate the original location of this corner.

Set 1 1/2" iron pipe with 2" brass cap projecting 18", stamped:

- Marked NBT's - S498
- Cedar 7" S3°E 19.25 feet T35N R11E
- B. Ash 8" S69°E 27.29 feet NW 1/16 S+32
- both scribed 1/16 BT CPI-1978

Dated at Rhineland, Wis., this 4th day of December, 1978

Signature Phillip T. Hansen Title Registered Land Surveyor Registration No. S-498
(County Surveyor, Registered Land Surveyor, or other duly authorized official)

Office of Register of Deeds, County of Oneida, I hereby certify that the within
instrument was filed in this office for record on the 16th day of January, 1979
at 10 o'clock P. M.

Dorcas Verage Nyckel
(Register of Deeds)

By..... Deputy

3511323030