

CERTIFIED LAND CORNER RESTORATION

Index No. Z-11

State of Wisconsin

County of Oneida } ss.



I Phillip T. Hansen, do hereby certify that on the 27th day of April, 1976, I found evidence of the quarter corner of Section 33-4 Township 34, North, Range 11 East, Fourth Principal Meridian, as described hereon; and that from this evidence I established a new monument and accessories as described hereon to perpetuate the original location of this corner.

Resident witnesses:

Glen Barker

Jim Claffin

Herb Lagoner

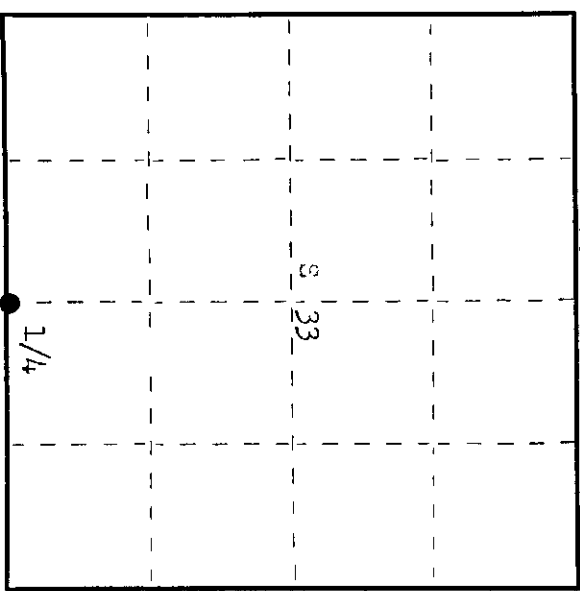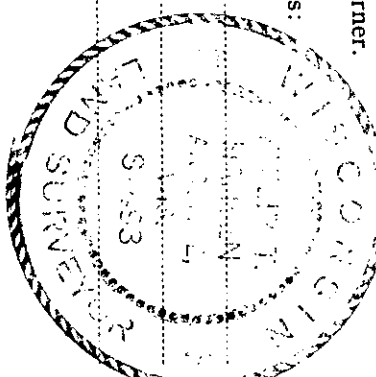

○ = Corner monument restored.

History of original corner establishment: Original corner established by Hiram C. Fellows, Deputy Surveyor in 1859, from which Maple 14" bears N32° E 20 lks. and Maple 9" bears N70° E 20 lks.

Corner recovered by H. C. Lawrence, Registered Land Surveyor, in 1948. Recovered 4" Hemlock Post, at 41.69 chs east of Section Corner common to Sec. 32-33, 5 and 4. Recovered Hemlock 16" S53° E 14 lks and Y. Birch 18" N64° W, 7 lks. Set a 5" cedar post squared and scribed for corner. Marked NBTs - Sugar 20" S71° E 23 lks. and Sugar 6" N5° E, 34 lks. A boulder outcrop 3 ft. x 4 ft. bears N 10° W 30 lks.

Description of corner evidence found:
Recovered 5" squared cedar post, scribed 43° 34', 40° 53' in fair condition. Also an old squared post, 2 ft. high beside it, scribed 40°. Found a rock cairn built around base.
Recovered OBT sugar 20" S71° E, 23 lks, scribed 40° NBT, corner 5" (8") N5° E, 34 lks, scribed 40°.

Description of monument and accessories I established to perpetuate the original location of this corner.

Replaced with 2" iron pipe with cap stamped
Pipe projects 2' above ground. Replaced rock cairn around base.
NBT Sugar 6" S19° E, 43.5 lks, scribed 40° BT.
Pipe and BTs painted blue.

T35N R11E
S 33
34
T34W R11E
S498-1976

Dated at Almeland, Wis., this 12th day of May, 1976

Signature Phillip T. Hansen Title Registered Land Surveyor Registration No. S-498
(County Surveyor, Registered Land Surveyor, or other duly authorized official)

Office of Register of Deeds, County of Oneida, I hereby certify that the within instrument was filed in this office for record on the 7th day of June, 1976 at 1:05 o'clock P. M.

Laura M. Meyer
(Register of Deeds)

By _____ Deputy

050011153