

CERTIFIED LAND CORNER RESTORATION


Index No. **Z-10**

State of Wisconsin


County of Oneida } ss.

I Philip T. Hansen, do hereby certify that on the 27th day of April, 1976, I found evidence of the W 1/16 corner of Section 4 and 33 Township 34 and 35 North, Range 11 West, Fourth Principal Meridian, as described hereon; and that from this evidence I established a new monument and accessories as described hereon to perpetuate the original location of this corner.

Resident witnesses:
Glen Barker
Jim Clarlin
Herb Wagoner

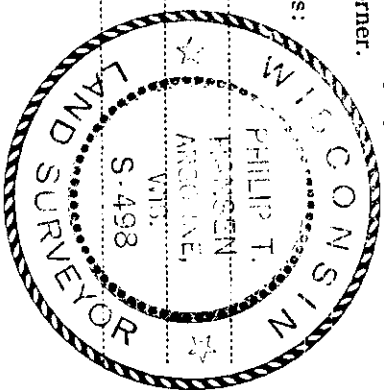

T35N R11E

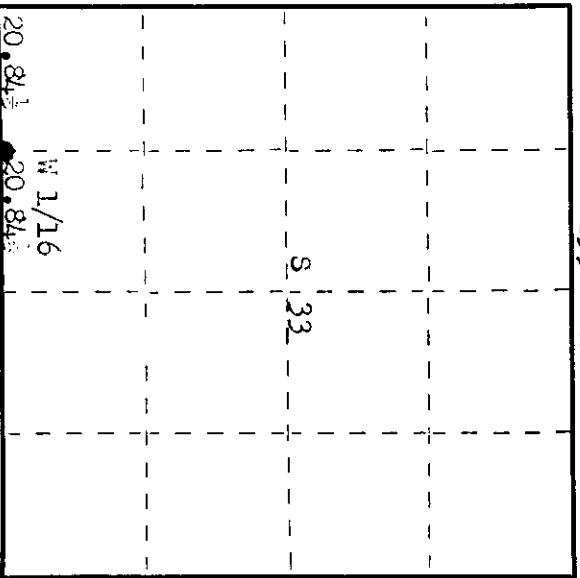

O = Corner monument restored.

History of original corner establishment: Corner established by H. C. Lawrence, registered land surveyor, in 1948. Ran a random line east from recovered section corner common to sections 32, 33, 4 and 5 a distance of 41.69 chains to a point 50 lks south of the 1/4 corner. Corrected line and set W1/16 corner at 20.84 1/2 chains, 25 lks, north. Set 4" naillock post. Marked NBTs - Double oak, 16" S30° 48 lks and W. asn 9" N22° 34 1/2 lks.

Description of corner evidence found: recovered 4" hemlock post, squared and scribed W1/16 S4, W1/16 S33 in good condition. Rock cairn built around base. Recovered OBTs, Double red oak 16" (18") S30° W, 48 lks. Scribed W1/16 S4 BT. White ash 9" (12") N22° E 34.5 lks. Scribed S33. Bottom scribe grown over.

Description of monument and accessories I established to perpetuate the original location of this corner.
Replaced hemlock post with 1 1/2" iron pipe with brass cap stamped
Pipe projects 18" above ground.
Placed rock cairn around base.
Pipe and BTs painted blue.
No additional accessories established

2498
T35N R11E
S 33
S 1/4
T34N R11E
1976

Dated at Oneida, Wis., this 27th day of April, 1976

Signature: *Philip T. Hansen* Title Registered Land Surveyor Registration No. S-498
County Surveyor, Registered Land Surveyor, or other duly authorized official

Office of Register of Deeds, County of Oneida. I hereby certify that the within instrument was filed in this office for record on the 4th day of June, 1976 at 1:00 o'clock P.M.

Norma Seage
(Register of Deeds)

By: Deputy

3511330030

