

CERTIFIED LAND CORNER RESTORATION



Index No. **X-13**

State of Wisconsin } ss.
 County of Oneida }

I Philip T. Hansen, do hereby certify that on the 24th day of March, 1976, I found evidence of the quarter corner of section 33 and 34 Township 35, North, Range 11 East, Fourth Principal Meridian, as described hereon; and that from this evidence I established a new monument and accessories as described hereon to perpetuate the original location of this corner.

Resident witnesses.

Jim Clafflin
Harb Jackson

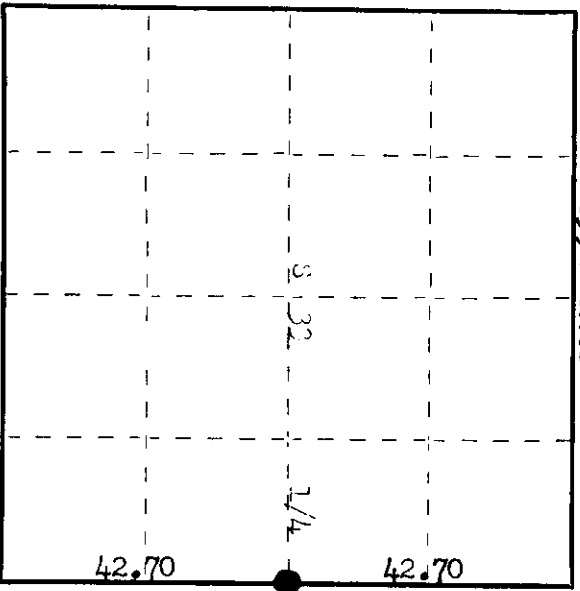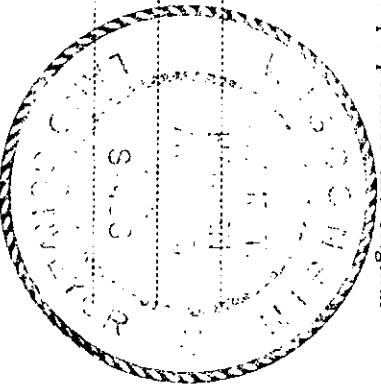

○ = Corner monument restored.

History of original corner establishment: Original corner established by Wm. W. Doucerty, Deputy Surveyor, in 1859, from which Birch 15" bears S32° 33' E 8.0 lks and Birch 15" bears S88° 15' E 8.0 lks. Corner recovered by D.H. Vaughan, County Surveyor, in 1901. Corner recovered by H.O. Lawrence, Registered Land Surveyor, in 1948. Run north 2° East from S 1/4 corner set by Hall at 20.85 chains, at 25.40 chains was 2.48 chains west of sec. corner 27, 28, 33 and 34. Corrected line to 36.401... Set 1/4 corner 1.34 chains east of 42.70. Marked BT. Birch 12" 385° 7' E 8 lks, which 6" S81° 2' 8 lks. Set 1/4 cedar post for corner.

Description of corner evidence found: recovered 1. recovered 4" squared cedar post, scribed 1/4 S33, S34. Birch 12" (14") S35° 7' 0 lks, scribed S33. Birch 6" (3") S75° 2' (T) 8.0 lks, scribed S34.

Description of monument and accessories I established to perpetuate the original location of this corner. Replaced cedar post with 2 1/2" diameter Federal monument, aluminum with magnet installed in cap and base. Cap stamped. Pipe projects 1" above ground. NBT - Maple 8" S50° 79.3 lks, scribed 1/4 BT. Pipe and BTs painted blue.

T35N R11E
 33 | 34
 1/4
 498-1976

Dated at Oneida, Wis. this 18th day of May, 1976.

Signature Philip T. Hansen Title Registered Land Surveyor Registration No. 498
 (County Surveyor, Registered Land Surveyor, or other duly authorized official)

Office of Register of Deeds, County of Oneida North day of June, 1976.
 I hereby certify that the within instrument was filed in this office for record on the 20th day of June, 1976 at 2:00 o'clock P. M.

Signature James H. Kunkel
 (Register of Deeds)

By James H. Kunkel Deputy

3511332000